

YAZOO
G80
2-17-71

MISSISSIPPI
BOARD OF WATER COMMISSIONERS
416 North State Street
Jackson, Mississippi 39201

CODED

WATER WELL DRILLERS LOG

Feb. 17 1971 E.M. "Bud" Casswell Yazoo
date well completed firm name county well located

LANDOWNER:
H.R. Crowder, Jr.
Yazoo City, Miss.
(mailing address)

description of formations encountered	from	to
<u>Clay</u>	<u>0</u>	<u>15</u>
<u>Sandy gravel</u>	<u>15</u>	<u>80</u>

WELL LOCATION:
sec. 15 T. 12 N R. 2 E
2 miles North of Yazoo
(distance) (direction) (nearest town)

WELL PURPOSE: Domestic
(home, irrigation, municipal, industrial)

WELL COMPLETION DATA:

(1) diameter (inches) 2 1/2

(2) total depth (feet) 80

(3) static water level (feet) 30 below top of ground.

(4) casing Steel, 75,
(material) (depth)
2 1/2"
(size) if telescope see back.

(5) screen 5ft., 75ft.
(length) (depth to top)
2", stainless
(size) (material)

(6) pump 1 10
(HP) (yield gpm)
0
(type power)

(7) electric log No
(yes or no)
0
(organization running log)

(8) how well bottom plugged steel plug

CODED


FEB 22 1971

MISS. BD. OF
WATER COMM.

DRILLERS REMARKS:

If well telescopes please sketch and show depths.

GROUND LEVEL

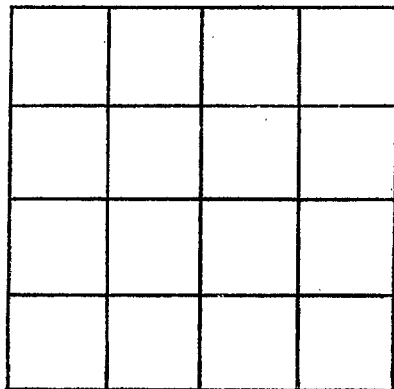

SECTION _____

Please indicate well location X.

ADDITIONAL INFORMATION

If more than one screen,
show locations of each on sketch.