

GW 12662

YAZOO CODED

683

EW # 245

MISSISSIPPI BOARD OF WATER COMMISSIONERS 416 North State Street Jackson, Mississippi 39201

WATER WELL DRILLERS LOG

9-29-

1972

Singer-Lump Central Div.

Yazoo

date well completed

firm name

county well located

LANDOWNER: City of Yazoo Public Service Commission Yazoo City, Miss (mailing address)

Table with 3 columns: description of formations encountered, from, to. Rows include Clay, Sand, Shale, and various streaks.

WELL LOCATION:

sec. 28 T. 12 N. R. 2 E

(distance) miles (direction) of (nearest town)

WELL PURPOSE: Municipal (home, irrigation, municipal, industrial)

WELL COMPLETION DATA:

- (1) diameter (inches) 18"
(2) total depth (feet) 982'
(3) static water level (feet) 20' below top of ground.
(4) casing Steel 890 (material) (depth)
(5) screen 80' 896' (length) (depth to top) 12" Stainless Steel (size) (material)
(6) pump 125 1500 (HP) (yield gpm) Electric (type power)
(7) electric log yes (yes or no) Miss. Geol. Survey (organization running log)
(8) how well bottom plugged Valve

Handwritten calculations: 896 - 80 = 816, 816 - 20 = 796


NOV 25 1972

DRILLERS REMARKS:

8

If well telescopes please sketch and show depths.

GROUND LEVEL

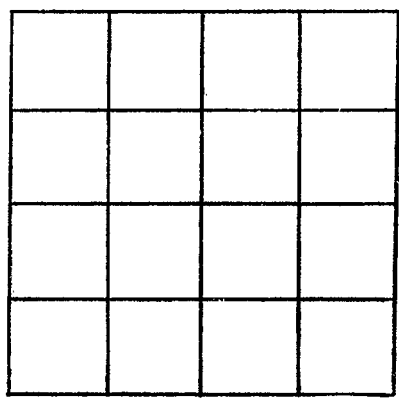

SECTION _____

Please indicate well location X.

ADDITIONAL INFORMATION

A series of horizontal lines providing space for additional information. The lines are evenly spaced and extend across the width of the form.

If more than one screen, show locations of each on sketch.