

YAZOO  
G 85  
4-30-74

MISSISSIPPI  
BOARD OF WATER COMMISSIONERS  
416 North State Street  
Jackson, Mississippi 39201

CODED

WATER WELL DRILLERS LOG

April 30 1974 F.M. "Bud" Cresswell YAZOO  
date well completed firm name county well located

LANDOWNER:  
O.H. BARBOUR  
Yazoo City, Miss.  
(mailing address)

description of formations encountered	from	to
Clay	0	80
Same	80	100
Clay	100	420
Peny Shale	420	565
Sand	565	660

WELL LOCATION:  
sec. 23 T. 12 N. R. 2 E  
1 miles North of Yazoo  
(distance) (direction) (nearest town)

WELL PURPOSE: Home  
(home, irrigation, municipal, industrial)

- WELL COMPLETION DATA:
- (1) diameter (inches) 2
  - (2) total depth (feet) 660
  - (3) static water level (feet) 195 below above top of ground.
  - (4) casing Steel 640  
(material) (depth)  
2 (size) if telescope see back.
  - (5) screen 20 640  
(length) (depth to top)  
2 Stainless  
(size) (material)
  - (6) pump Air Compressor  
(HP) (yield gpm)  
0 (type power)
  - (7) electric log No  
(yes or no)  
0 (organization running log)
  - (8) how well bottom plugged  
Steel Plug


CODED

RECORDED  
MAY 21 1974

DRILLERS REMARKS:

If well telescopes please sketch and show depths.

GROUND LEVEL

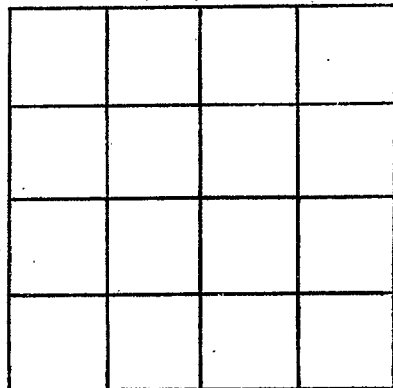

SECTION \_\_\_\_\_

Please indicate well location X.

ADDITIONAL INFORMATION

If more than one screen, show locations of each on sketch.