

**MISSISSIPPI
BOARD OF WATER COMMISSIONERS**
416 North State Street
Jackson, Mississippi 39201

CODED

WATER WELL DRILLERS LOG

YAZOO
686
11-20-74

Nov. 20 1974 E.M. "Bud" Cresswell YAZOO
date well completed firm name county well located

LANDOWNER:	description of formations encountered	from	to
Robert McMASTER Yazoo City, Miss. (mailing address)			

WELL LOCATION:
sec. 7 T 12 N R 2 E
7 miles North of YAZOO
(distance) (direction) (nearest town)

WELL PURPOSE: home
(home, irrigation, municipal, industrial)

- WELL COMPLETION DATA:**
- (1) diameter (inches) 2
 - (2) total depth (feet) 400
 - (3) static water level (feet) 110 below above top of ground.
 - (4) casing Steel 380
(material) (depth)
2 if telescope see back.
(size)
 - (5) screen 20 380
(length) (depth to top)
2 STAINLESS
(size) (material)
 - (6) pump Air Compressor
(HP) (yield gpm)
0
(type power)
 - (7) electric log No
(yes or no)
0
(organization running log)

CODED


(8) how well bottom plugged
Steel Plug

DRILLERS REMARKS:

RECORDED
INDEXED
DEC - 9 1974

If well telescopes please sketch and show depths.

GROUND LEVEL

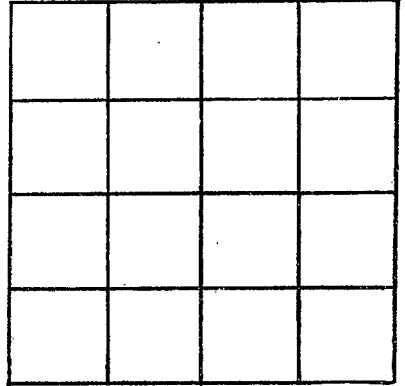

SECTION _____

Please indicate well location X.

ADDITIONAL INFORMATION

If more than one screen,
show locations of each on sketch.