

YA200  
 687  
 Elev # 271  
 3-15-77

MISSISSIPPI  
 BOARD OF WATER COMMISSIONERS  
 416 North State Street  
 Jackson, Mississippi 39201

CODED

WATER WELL DRILLERS LOG

7-15-1977 date well completed      77 Jefcoat Drilling Co firm name      Yazoo county well located

LANDOWNER: Standard Oil Company Bulkhead, Yazoo City Miss  
 (mailing address)

WELL LOCATION:  
 sec. 29 T. 12 N R. 3 W  
3/4 miles NW of Yazoo City  
 (distance) (direction) (nearest town)

WELL PURPOSE: Industrial  
 (home, irrigation, municipal, industrial)

WELL COMPLETION DATA:

- (1) diameter (inches) 4 X 2
- (2) total depth (feet) 992
- (3) static water level (feet) 26 below top of ground.
- (4) casing steel, 992  
 (material) (depth)  
4 X 2" if telescope see back.  
 (size)
- (5) screen 30 ft, 957  
 (length) (depth to top)  
2", Stainless steel  
 (size) (material)
- (6) pump 2 38  
 (HP) (yield gpm)  
AC  
 (type power)
- (7) electric log yes  
 (yes or no)  
MRS  
 (organization running log)
- (8) how well bottom plugged Steel Plug

description of formations encountered	from	to
Clay & Topsoil	0	35
Shale	35	97
gravel	97	127
sand	127	219
shale	219	311
sand with shale	311	525
sand	525	586
sand with shale & and layers of small pebbles	586	769
sand	769	918
shale	918	918
sand	918	1004

CODED

bottom well set 992 + 0


THE MISSISSIPPI  
 BOARD OF WATER COMMISSIONERS  
 AUG 11 1977

MISS. RD. OF WATER COMMISSIONERS

DRILLERS REMARKS:

If well telescopes please sketch and show depths.

GROUND LEVEL

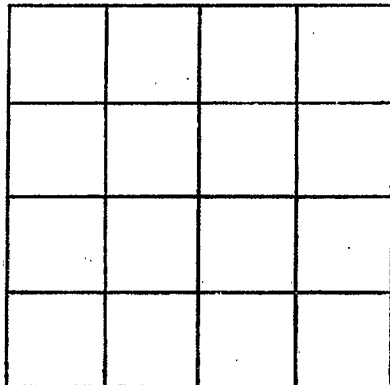

SECTION \_\_\_\_\_

Please indicate well location X.

ADDITIONAL INFORMATION

If more than one screen, show locations of each on sketch.