

MISSISSIPPI DEPARTMENT OF NATURAL RESOURCES

Bureau of Land and Water Resources

Southport Mall

P.O. Box 10631

Jackson, Mississippi 39209

WATER WELL DRILLERS LOG

Yazoo
G 94
5-25-81

5/25/1981 *Jerry Barrios* *Dyer* Yazoo
date well completed *Dyer* firm name county well located

LANDOWNER: *Jerry Barrios*

description of formation encountered	from	to
Clay	0	18
Sand	18	77
Clay	77	80
Sand & gravel	80	110

Yazoo City, MS.
(mailing address)

WELL LOCATION:
sec. 20 T. 12 N. R. 2 E.
S. W.
1 miles W of Yazoo City
(distance) (direction) (nearest town)


WELL PURPOSE:
(home, irrigation, municipal, industrial)

WELL COMPLETION DATA:

- (1) diameter (inches) 16"
- (2) total depth (feet) 110'
- (3) static water level (feet) 20' below top of ground.
- (4) casing Steel, 110',
(material) (depth)
16" if telescope see back.
(size)
- (5) screen 40', 70'
(length) (depth to top)
16", Steel
(size) (material)
- (6) pump 125 1200
(HP) (yield gpm)
Diesel
(type power)
- (7) electric log
(yes or no)

(organization running log)
- (8) how well bottom plugged plate

CODED

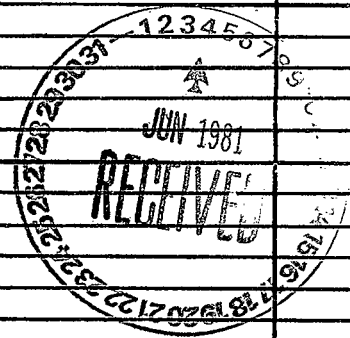


DRILLERS REMARKS:

0

If well telescopes please sketch and show depths.

GROUND LEVEL

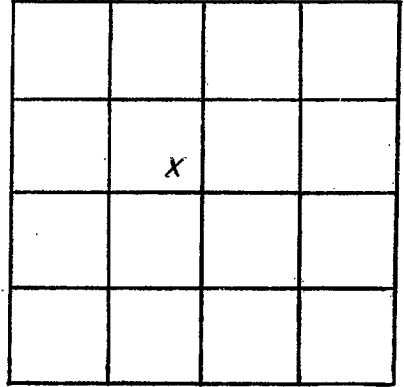

SECTION 20

Please indicate well location X.

ADDITIONAL INFORMATION

If more than one screen, show locations of each on sketch.