

Yazoo
696
4-29-81

MISSISSIPPI
BOARD OF WATER COMMISSIONERS
416 North State Street
Jackson, Mississippi 39201

WATER WELL DRILLERS LOG

Apr. 28 1981 Dieuling & Assoc Yazoo
date well completed firm name county well located

LANDOWNER: Cliff Phillips
Holly Bluffs, MS
39088
(mailing address)


WELL LOCATION:
sec. 28 T. 12 (N) S R. 2 E W
3 miles NW of Eden
(distance) (direction) (nearest town)

WELL PURPOSE: Private
(home, irrigation, municipal, industrial)

WELL COMPLETION DATA:

- (1) diameter (inches) 11 1/2"
- (2) total depth (feet) 114'
- (3) static water level (feet) 15' below top of ground.
- (4) casing STEEL, 84',
(material) (depth)
(size) If telescope, see back.
- (5) screen 40', 84'
(length) (depth to top)
16", STEEL
(size) (material)
- (6) pump 60, 3800
(HP) (yield gpm)
Diesel
(type power)
- (7) electric log NO
(yes or no)
NIC
(organization running log)
- (8) how well bottom plugged Steel Plug

description of formations encountered	from	to
Top Soil	0	5
CLAY	5	10
CLAY	10	15
CLAY	15	20
CLAY	20	25
CLAY & FINE SAND	25	30
"	30	35
"	35	40
CLAY + MED SAND	40	45
COURSE SAND + GRAV	45	50
CLAY + MED SAND	50	55
COURSE SAND & GRAV LIQ	55	60
CLAY MED SAND	60	65
CLAY, COAL FINE & M.S.	65	70
CLAY MED SAND & GRAV	70	75
MED. + COURSE SAND CL	75	80
COURSE SAND GRAV COAL	80	85
COURSE SAND GRAV	85	90
"	90	95
" COAL	95	100
" CLAY	100	105
CLAY	105	110
Bottom of Hole	110	114

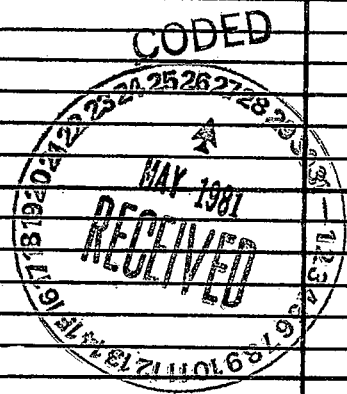

DRILLERS REMARKS:

②

If well telescopes please sketch and show depths.

GROUND LEVEL

SECTION _____

Please indicate well location X.

ADDITIONAL INFORMATION

If more than one screen, show locations of each on sketch.