

MISSISSIPPI DEPARTMENT OF NATURAL RESOURCES

Bureau of Land and Water Resources

Southport Mall

P.O. Box 10631

Jackson, Mississippi 39209

WATER WELL DRILLERS LOG

CODED

YAZOO
 597
 12-23-80

12/23 1980 date well completed Larry's well & Pump firm name Yazoo county well located

LANDOWNER: Archie Edgers	description of formations encountered		from	to
Yazoo City Ms. (mailing address)	CLAY		0	30
	FINE SAND + CLAY		30	60
	FINE SAND		60	70
	COARSE SAND GRAVEL		70	130
WELL LOCATION: sec. 3 T 12 N R 2 E 4 miles N of Yazoo City (distance) (direction) (nearest town)				
WELL PURPOSE: Catfish (home, irrigation, municipal, industrial)				
WELL COMPLETION DATA: (1) diameter (inches) 16" (2) total depth (feet) 130' (3) static water level (feet) 6 below top of ground. (4) casing Steel (material), 90' (depth) (size) If telescope see back. (5) screen 16" (length), 90' (depth to top) (size) (material) steel (6) pump 100 (HP), 3000 (yield gpm) (type power) (7) electric log No (yes or no) (organization running log) (8) how well bottom plugged Steel Plate				

CODED

DEPT. OF NATURAL RESOURCES
 BUREAU OF LAND & WATER RESOURCES

OCT 15 1981


RECEIVED

DRILLERS REMARKS:

①

If well telescopes please sketch and show depths.

GROUND LEVEL

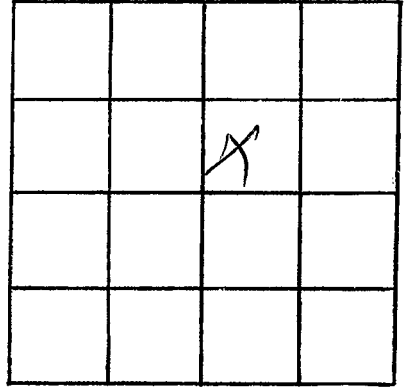

SECTION 3

Please indicate well location X.

ADDITIONAL INFORMATION

If more than one screen,
show locations of each on sketch.