

YAZOO

WATER WELL DRILLERS LOG

Date: MARCH 11, 1963, Driller: J. G. BARNES County YAZOO
(Name)

(1) Owner of Land: W. T. CLARK
(Name)
YAZOO CITY ROUT 4
(Address)

(2) Location: S-W 1/4, SE 1/4, Sec. 5 1/2 N 2W R
6 miles NW of YAZOO
(distance) (direction) (Nearest Town)

(3) Topography: FLAT
(Hilly) (Flat) (Level)

(4) Purpose of Well: FARM
(Domestic Irrigation Municipal, Industrial, Other)

Description & Color of Materials Sand, Clay, Red Clay, Shell, etc.	Thick- ness Feet	Depth Feet
LIGHT COLORED CLAY	10	10
SAND	130	140
GRAVEL	30	170
BLUE CLAY	41	211
SAND	200	411
SCATTER SAND & SHELL	190	601
DARK SHELL	200	801
ROCK & SHELL	30	831
SHELL	100	931
SHELL & SAND	70	1001
SHELL	84	1085
SAND	49	1134

Information upon completion of well:

(1) Diameter 4" inches.

(2) Total Depth 1134 feet.

(3) Water Level 20 feet below top of ground.

(4) Cased to 1099, Size 4" - 2"

(5) Screen: Size .006, Length 30

(6) Were any formations sealed against pollution?
 _____ yes, _____ no.

1134


THIS PUMP HAS A ONE YEAR GUARANTEED
WEHH 10-339EE GOULDS
1 H.P. SUBMERSIBLE PUMP
THE WELL HAS A FIVE YEAR GUARANTEED.

189 FEET 4" PIPE
1 1/2 X 2 1/2 LEAD SEAL
945 FEET 2" PIPE
30 FEET WELL SCREEN.

If YES depth of formation _____

Why _____

Drillers Remarks: _____

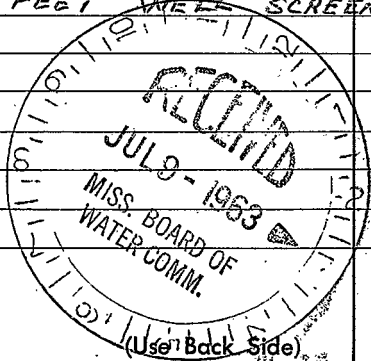

Well No.

