

YAZOO
G 2000
67

MISSISSIPPI
BOARD OF WATER COMMISSIONERS
416 North State Street
Jackson, Mississippi 39201

WATER WELL DRILLERS LOG

date well completed 1967 firm name McCannell Drilling Co. county well located Yazoo

LANDOWNER: Bob Rhodes
Yazoo City, Miss.
(mailing address)

description of formations encountered	from	to
clay	0	90
sand	90	95
clay	95	380
sand	380	426
lignite & sand	426	495

WELL LOCATION:
sec. 2 T. 12 N R. 2 E
4 miles N of Yazoo City
(distance) (direction) (nearest town)

WELL PURPOSE: Industrial
(home, irrigation, municipal, industrial)

- WELL COMPLETION DATA:
- (1) diameter (inches) 3"
 - (2) total depth (feet) 435
 - (3) static water level (feet) 60 below above top of ground.
 - (4) casing 2" pipe, 400'
(material) (depth)
 if telescope see back.
(size)
 - (5) screen 20', 400'
(length) (depth to top)
3", Stainless Steel
(size) (material)
 - (6) pump 1 1/2, 5 G.P.M.
(HP) (yield gpm)
Elec.
(type power)
 - (7) electric log No
(yes or no)

(organization running log)


(8) how well bottom plugged Steel Ball

DRILLERS REMARKS:



If well telescopes please sketch and show depths.

GROUND LEVEL

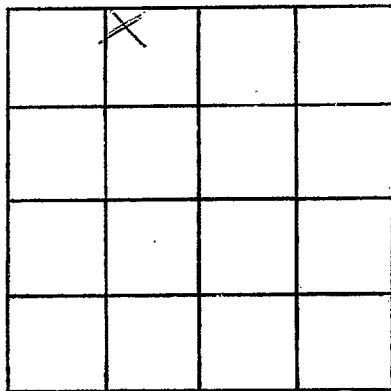

SECTION 2

Please indicate well location X.

ADDITIONAL INFORMATION

If more than one screen,
show locations of each on sketch.