

YAZOO
G 2003
- 67

MISSISSIPPI
BOARD OF WATER COMMISSIONERS
416 North State Street
Jackson, Mississippi 39201

WATER WELL DRILLERS LOG

date well completed 1967 McConnell Drilling firm name Yazoo county well located

LANDOWNER: R.W. Haleman

description of formations encountered	from	to
Top Sand	0	10
Red & Yellow Clay	10	109
Sand	109	114
Blue clay	114	409
Sand	409	435


Yazoo City, Miss.
(mailing address)

WELL LOCATION:
sec. 2 T. 12 N. S. R. 2 W.
miles _____ of _____
(distance) (direction) (nearest town)

WELL PURPOSE: Home
(home, irrigation, municipal, industrial)

- WELL COMPLETION DATA:
- (1) diameter (inches) 2"
 - (2) total depth (feet) 435
 - (3) static water level (feet) 160 below above top of ground.
 - (4) casing 2" Steel, 425'
(material) (depth)
_____ if telescope see back.
(size)
 - (5) screen 10', 425'
(length) (depth to top)
2", Stainless Steel
(size) (material)
 - (6) pump 2 1/2 6
(HP) (yield gpm)
6/60c
(type power)
 - (7) electric log No
(yes or no)

(organization running log)
 - (8) how well bottom plugged Back wash
valve

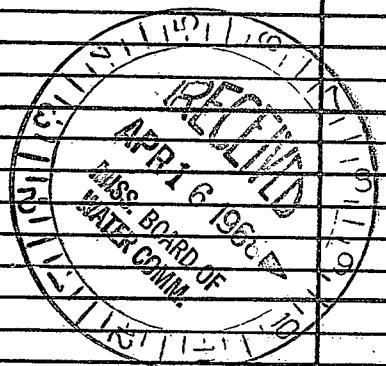

DRILLERS REMARKS:

