

YAZOO
G 2004
-67

MISSISSIPPI
BOARD OF WATER COMMISSIONERS
416 North State Street
Jackson, Mississippi 39201

WATER WELL DRILLERS LOG

date well completed 19 67 McConnell Drilling firm name Yazoo county well located

LANDOWNER: Robert Martin
Benton Miss.

| description of formations encountered | from | to |
|---------------------------------------|------------|------------|
| <u>Top Soil</u> | <u>0</u> | <u>6</u> |
| <u>Red & Yellow Clay</u> | <u>6</u> | <u>112</u> |
| <u>Blue Clay</u> | <u>112</u> | <u>385</u> |
| <u>SAND</u> | <u>385</u> | <u>425</u> |
| <u>white sand</u> | <u>425</u> | <u>427</u> |

(mailing address)

WELL LOCATION:
4 sec. ~~12~~ 12 N R 2 E
S W
2 1/4 miles NW of midway
(distance) (direction) (nearest town)


WELL PURPOSE: Home
(home, irrigation, municipal, industrial)

WELL COMPLETION DATA:

- (1) diameter (inches) 2"
- (2) total depth (feet) 427'
- (3) static water level (feet) 130 below above top of ground.
- (4) casing Steel, 405'
(material) (depth)
2"
(size) If telescope see back.
- (5) screen 10', 405'
(length) (depth to top)
2", Stainless Steel
(size) (material)
- (6) pump _____ (HP) _____ (yield gpm)

(type power)
- (7) electric log No
(yes or no)

(organization running log)
- (8) how well bottom plugged Backwash
valve

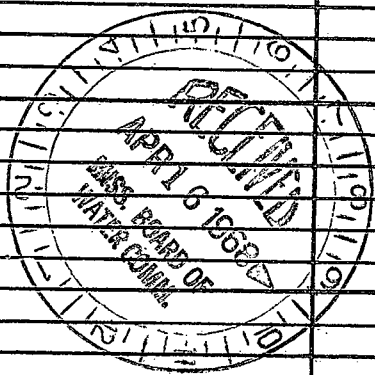


DRILLERS REMARKS: He furnished & installed own pump.

If well telescopes please sketch and show depths.

GROUND LEVEL

~~40.5'~~
~~2"~~

~~10'~~
~~SCREEN~~

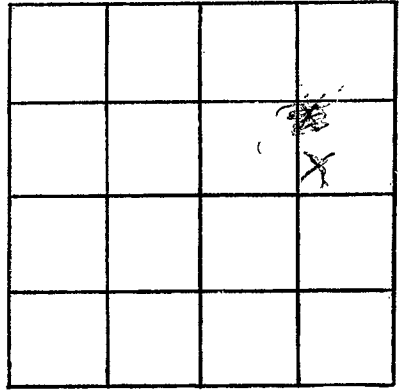

SECTION ~~#4~~ 4

Please indicate well location X.

ADDITIONAL INFORMATION

Multiple horizontal lines for additional information.

If more than one screen, show locations of each on sketch.