

**MISSISSIPPI DEPARTMENT OF ENVIRONMENTAL
QUALITY**
Office of Land and Water Resources

P. O. Box 10631
Jackson, MS 39289-0631

WATER WELL DRILLERS LOG

COUNTY WELL LOCATED	
Yazoo	
WELL NUMBER	CODED
C-2009	
DATE WELL COMPLETED	
Feb. 22, 1996	

PERMIT NUMBER
NAME OF DRILLING FIRM
E M Bud Cresswell
<u>BENTONIA, MS</u> <i>39022</i>

NAME & MAILING ADDRESS OF LANDOWNER		
JAMES RIVER CO. P.		
Yazoo City, MS - 39194		
WELL LOCATION: SEC TOWNSHIP RANGE		
30	12 N	2 W
DISTANCE DIRECTION NEAREST TOWN		
1	Miles West	of Yazoo City
OTHER LANDMARK		
AT CHIP MILL		
WELL PURPOSE: Home, Irrigation, Municipal, Industrial, Fish Pond, etc.		

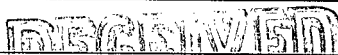
PUMP DATA		
PUMP TYPE (Circle One):		
<input checked="" type="radio"/> Submersible	<input type="radio"/> Turbine,	<input type="radio"/> Jet <input type="radio"/> Flowing Well,
Other (Describe)		
POWER TYPE (Circle One):		
<input checked="" type="radio"/> Electric	<input type="radio"/> Tractor, Diesel,	<input type="radio"/> Gasoline, <input type="radio"/> Butane,
Other (Describe)		
Pump Capacity (GPM)	No. of Stages	Setting Depth
75	8	63 FT.
PUMP TEST		
Well yielded	100	GPM with
a drawdown of	10	ft.
after	1/2	hours of pumping

WELL DATA		
Well Depth	Casing Diameter (In.)	Casing Length (Ft.)
100	4	60
Type of Casing	Hole Depth	Depth to Static Water Level
PVC	100	15
TYPE OF COMPLETION: (Circle One or More):		
<input type="radio"/> Gravel Packed,	<input type="radio"/> Underreamed,	<input type="radio"/> Telescoped,
<input checked="" type="radio"/> Natural Development,	<input type="radio"/> Open Hole,	<input type="radio"/> Other
(Describe)		
WELL GROUTED TO A DEPTH OF 20 FEET		
Type Grout (circle one): Cement, Bentonite, or Mix		

LOG DATA	
TYPE OF LOG RUN (Circle One):	
<input type="radio"/> Electric, Gamma Ray, Density, Sonic, Neutron,	<input checked="" type="radio"/> No Log-Run,
Other (Describe)	
Name of Organization Running Log	

SCREEN DATA		
Diameter - Inches	Length - Feet	Slot Size - Inches
4	40	.016
Screen Type	Depth to Bottom - Feet	
PVC	100	

GEOLOGIC DATA (Office Use Only)			
Surface Elev.	Geologic Unit	Unit Thickness	Depth to Top
Subs. SWL	Date	Analysis	Aquifer Test

Driller's Remarks
 MAR 05 1996

DESCRIPTION OF FORMATIONS ENCOUNTERED	FROM	TO
SURFACE DEPOSITS	0	12
SAND- GRAVEL	12	100

FORMATIONS (Continued)	FROM	TO
Dept. of Environmental Quality Office of Land & Water Resources		
IF MORE SPACE IS NEEDED, USE BACK		

If well telescopes please
sketch and show depths.

GROUND LEVEL

SECTION _____

Please indicate well location X.

ADDITIONAL INFORMATION

If more than one screen,
show location of each on sketch.