

YAZOO
H13
4-1-71

MISSISSIPPI
BOARD OF WATER COMMISSIONERS
416 North State Street
Jackson, Mississippi 39201

CODED

WATER WELL DRILLERS LOG

April 1 1971 McConnell Drilling Yazoo
Date well completed firm name county well located

LANDOWNER:

Mr. James O. Carter
Rt. 2, Box 340 Yazoo
(mailing address)

description of formations encountered

from to

| description of formations encountered | from | to |
|---------------------------------------|------|-----|
| clay | 0 | 85 |
| sand & gravel | 85 | 100 |
| blue clay | 100 | 151 |
| sand (fine) | 151 | 180 |
| blue clay, sand | 180 | 184 |
| soft lignite. | | |

WELL LOCATION:

sec. 5 T. 12 N. R. 1 E
5 miles NE of Yazoo
(distance) (direction) (nearest town)

WELL PURPOSE: farm & home
(home, irrigation, municipal, industrial)

WELL COMPLETION DATA:

- (1) diameter (inches) 4"
- (2) total depth (feet) 180'
- (3) static water level (feet) 75 below above
top of ground.
- (4) casing steel, 1 1/2",
(material) (depth)
4"
(size) If telescope see back.
- (5) screen 20', 1 1/2"
(length) (depth to top)
2", stainless
(size) (material)
- (6) pump 1 20
(HP) (yield gpm)
elect.
(type power)
- (7) electric log No
(yes or no)

(organization running log)

(8) how well bottom plugged
back wash water

DRILLERS REMARKS:

Gravel packed.


CODED

MAY 10 1971

MISS. BD. OF
WATER COMM.

If well telescopes please sketch and show depths.

GROUND LEVEL

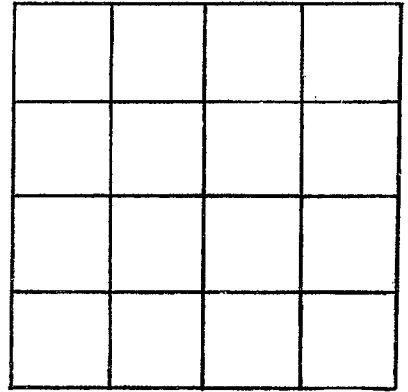

SECTION _____

Please indicate well location X.

ADDITIONAL INFORMATION

If more than one screen, show locations of each on sketch.