

YA200
 @ H15
 6-4-65

MISSISSIPPI BOARD OF WATER COMMISSIONERS

CODED

WATER WELL DRILLERS LOG

Date: 6/4, 1965, Driller: M. Kay County: Zeno
 (C.B. Poark?) (Name)

(1) Owner of Land: Mr. Rook
 (Name)
Zeno City
 (Address)

(2) Location: 1/4, 1/4, Sec. 13 T12R1W,
10 miles E of Edwards
 (distance) (direction) (Nearest Town)

(3) Topography: (Hilly) (Flat) (Level)

(4) Purpose of Well: Home
 (Domestic Irrigation
 Municipal, Industrial, Other)

Description & Color of Materials Sand, Clay, Red Clay, Shell, etc.	Thick- ness Feet	Depth Feet
<u>Red Clay</u>	<u>0</u>	<u>20</u>
<u>Red Clay</u>	<u>20</u>	<u>40</u>
<u>Red Sand</u>	<u>40</u>	<u>60</u>
<u>Red Sand - Gravel</u>	<u>60</u>	<u>100</u>
<u>Blue Clay</u>	<u>100</u>	<u>120</u>
<u>Blue Clay</u>	<u>120</u>	<u>200</u>
<u>Sandy Shale</u>	<u>200</u>	<u>240</u>
<u>Sand</u>	<u>240</u>	<u>280</u>
<u>Sandy Shale</u>	<u>280</u>	<u>248</u>
<u>Rock</u>	<u>248</u>	<u>252</u>
<u>Shale</u>	<u>252</u>	<u>300</u>
<u>Rock</u>	<u>300</u>	<u>387</u>
<u>Shale</u>	<u>387</u>	<u>400</u>
<u>Fine Sand</u>	<u>400</u>	<u>420</u>
<u>Shale</u>	<u>420</u>	<u>440</u>
<u>Shale</u>	<u>440</u>	<u>460</u>
<u>Med Sand</u>	<u>460</u>	<u>525</u>
<u>Quarant</u>		

Information upon completion of well:

(1) Diameter 2 inches.

(2) Total Depth 525 feet.

(3) Water Level 132 feet below top of ground.


(4) Cased to 0, Size 0

(5) Screen: Size 007, Length 20

(6) Were any formations sealed against pollution?
 yes, no.

If YES depth of formation _____
 Why _____
 Drillers Remarks: _____

CODED

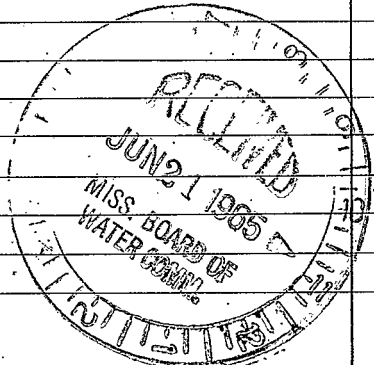

(Use Back Side)

Well No.

Faint, illegible text, possibly bleed-through from the reverse side of the page.

1900
1901
1902