

MISSISSIPPI
BOARD OF WATER COMMISSIONERS
416 North State Street
Jackson, Mississippi 39201

CODED

WATER WELL DRILLERS LOG
JEFCOAT DRILLING CO.

YAZOO
H17
11-16-76
Elog # 270
Nov 16 1976
date well completed

firm name

Yazoo
county well located

LANDOWNER: Bernie Evans
Benton Rt 2
(mailing address)

description of formations encountered	from	to
Clay Tan soil	0	130
M.S. sand	130	138
Shale & sandy shale	138	340
fine sand	340	358
shale	358	370
Sand	370	385
		70

WELL LOCATION:
sec. 7 T. 12 N. R. 1 W.
8 miles W of Yazoo
(distance) (direction) (nearest town)

WELL PURPOSE: none
(home, irrigation, municipal, industrial)

- WELL COMPLETION DATA:
- (1) diameter (inches) 2"
 - (2) total depth (feet) 385
 - (3) static water level (feet) 130 below top of ground.
 - (4) casing PVC, 373,
(material) (depth)
(size) If telescope see back.
 - (5) screen 12H, 373
(length) (depth to top)
2, PVC
(size) (material)
 - (6) pump air, 20
(HP) (yield gpm)
AC
(type power)
 - (7) electric log yes
(yes or no)
M.S.
(organization running log)
 - (8) how well bottom plugged backwash


CODED

DRILLERS REMARKS:

RECEIVED
MAY 19 1977

If well telescopes please
sketch and show depths.

GROUND LEVEL

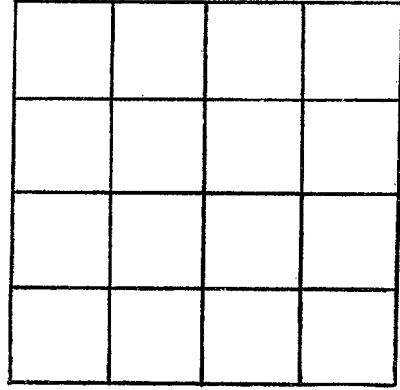

SECTION _____

Please indicate well location X.

ADDITIONAL INFORMATION

A series of horizontal lines for recording additional information.

If more than one screen,
show locations of each on sketch.