

YA200
H19
8-10-79

MISSISSIPPI
BOARD OF WATER COMMISSIONERS
416 North State Street
Jackson, Mississippi 39201

H-18

E-LOG# 280
CODED

WATER WELL DRILLERS LOG

Aug 10 1979 date well completed
Jeffcoat Drilling Co. firm name
Yazoo county well located

LANDOWNER:	description of formations encountered	from	to
Clarence Powell Benton, MS (mailing address)			
WELL LOCATION:			
sec. 12 T. 12 N. R. 1 W.			
4.5 miles N/W of Benton (distance) (direction) (nearest town)			
WELL PURPOSE: none (home, irrigation, municipal, industrial)			380 TD
WELL COMPLETION DATA:			
(1) diameter (inches) 2			
(2) total depth (feet) 380			
(3) static water level (feet) 155 below top of ground.			
(4) casing PVC, 360, (material) (depth) 2" (size) if telescope see back.			
(5) screen 20, 360 (length) (depth to top) 2" PVC (size) (material)			
(6) pump 1, 10 (HP) (yield gpm) AC (type power)			
(7) electric log yes (yes or no) M.H.B. (organization running log)			
(8) how well bottom plugged backwash			
DRILLERS REMARKS:			

CODED


DEPT. OF NATURAL RESOURCES
BUREAU OF LAND & WATER RESOURCES

SEP 12 1980
RECEIVED

If well telescopes please sketch and show depths.

SW/Com. Sec. 11
To 1250' E. 20016
Line.

GROUND LEVEL

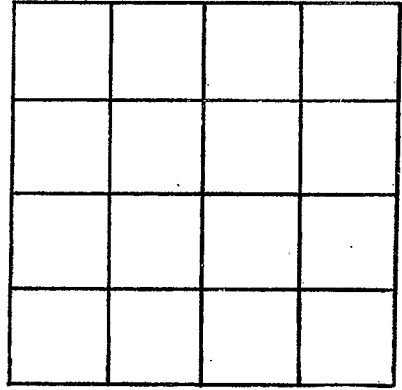

SECTION _____

Please indicate well location X.

ADDITIONAL INFORMATION

If more than one screen, show locations of each on sketch.