

MISSISSIPPI DEPARTMENT OF NATURAL RESOURCES

Bureau of Land and Water Resources

Southport Mall

P.O. Box 10631

Jackson, Mississippi 39209

CODED

WATER WELL DRILLERS LOG

Griner Drilling Service, Inc.

42700

42700  
H-20  
12-8-81  
12-8-81

date well completed

firm name

county well located

LANDOWNER:  
Dome Petroleum  
1675 Broadway  
Suite 2900  
Denver, Colorado  
(mailing address)

description of formations encountered

from

to

WELL LOCATION: 800' N + 450' E  
sec. 33 T. 120 S R. 1 E SW/4  
No. 1-33  
8 miles 42700 City  
(distance) miles (direction) of (nearest town)

SAND

0 42

clay, rock

42 360

SAND, real fine

360 385

streaked, mostly clay

385 529

WELL PURPOSE: oil field supply  
(home, irrigation, municipal, industrial)

SAND

529 650

WELL COMPLETION DATA:

- (1) diameter (inches) 3"
- (2) total depth (feet) 672'
- (3) static water level (feet) 75' below top of ground.
- (4) casing steel 651' (material) (depth) 3" (size) if telescope see back.
- (5) screen 42' 609' (length) (depth to top) 3" perforated (size) (material)
- (6) pump — 75 (HP) (yield gpm) AC (type power)
- (7) electric log — (yes or no) (organization running log)

clay

650 672

CODED

DEPT. OF NATURAL RESOURCES  
BUREAU OF LAND & WATER RESOURCES

DEC 23 1981


(8) how well bottom plugged orange

RECEIVED

DRILLERS REMARKS:

If well telescopes please sketch and show depths.

GROUND LEVEL

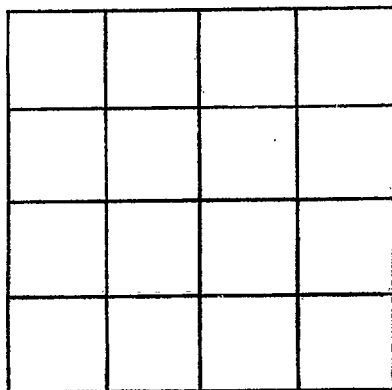

SECTION \_\_\_\_\_

Please indicate well location X.

ADDITIONAL INFORMATION

If more than one screen,  
show locations of each on sketch.