

YA200

H 2001

4-62

MISSISSIPPI BOARD OF WATER COMMISSIONERS

WATER WELL DRILLERS LOG

Page 1 of 1

Date: April, 1962, Driller: Daniel Benney County: Yazoo

(Name)

(1) Owner of Land: H. L. Mathew
 (Name)
Yazoo City, Miss.
 (Address)

(2) Location: 1/4, 1/4, Sec. 3 T12R1
 miles of Yazoo City
 (distance) (direction) (Nearest Town)

(3) Topography: Hilly
 (Hilly) (Flat) (Level)

(4) Purpose of Well: Domestic
 (Domestic Irrigation
 Municipal, Industrial, Other)

Description & Color of Materials Sand, Clay, Red Clay, Shell, etc.	Thick- ness Feet	Depth Feet
Surface	20	20
Yellow clay	20	40
Yellow clay	20	60
Sand	10	70
White clay	20	90
Blue clay	20	100
" "	20	120
" "	20	140
(Rock at 130')		
Blue clay	20	160
" "	20	180
(Rock at 165')		
Blue clay	20	200
(Rock at 195'-192'-198')		
Brown shale	20	220
Brown shale streak of sand	20	240
Brown shale	20	260
" "	20	280
Brown shale & sand	20	300
Sandy shale	20	320
Shale	20	340
Shale streak of sand	20	360
" " " "	20	380
" " " "	20	400
" " " "	20	420
Sand	20	440
" "	20	460
(Sand streak of sand)	20	480

Information upon completion of well:

(1) Diameter 4 1/2 inches.

(2) Total Depth 1110 feet.

(3) Water Level 195 feet below top of ground.

(4) Cased to 633, Size 4"


(5) Screen: Size 2", Length 30'

(6) Were any formations sealed against pollution?
 yes, no.

If YES depth of formation _____

Why _____

Drillers Remarks: _____

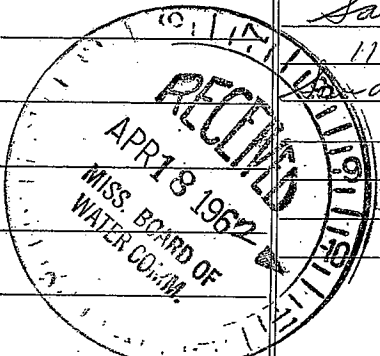

(Use Back Side)

Well No.

Retain this copy for your office files.

1870
1871
1872
1900