

MISSISSIPPI DEPARTMENT OF NATURAL RESOURCES

Bureau of Land and Water Resources

Southport Mall

P.O. Box 10631

Jackson, Mississippi 39209

WATER WELL DRILLERS LOG

4200
H 200

Feb. 14 1986 E.M. "Bud" Cresswell 4200
 date well completed firm name county well located

LANDOWNER:
 JACK COKER
 4200 City, Ms. 39194
 (mailing address)

description of formations encountered	from to	
	ft	ft
Surface	0	45
Blue Clay	45	160
Sand	160	240
Shale - lignite	240	310
Sand	310	320
Shale	320	460
Sand	460	500

WELL LOCATION:
 sec. 7 T. 12 N. R. 1 W.
 5 miles NE of 4200 City
 (distance) (direction) (nearest town)

WELL PURPOSE: Home
 (home, irrigation, municipal, industrial)

- WELL COMPLETION DATA:
- (1) diameter (inches) 2
 - (2) total depth (feet) 500
 - (3) static water level (feet) 110 below surface top of ground.
 - (4) casing PVC 460 (material) (depth)
 2 (size) If telescope see back.
 - (5) screen 40 460 (length) (depth to top)
 2 PVC (size) (material)
 - (6) pump air 30 (HP) (yield gpm)
 - (7) electric log no (yes or no)
 - (organization running log)
 - (8) How well bottom plugged
 Oak Wash Valve


DRILLERS REMARKS:

RECEIVED
 FEB 20 1986

Department of Natural Resources
 Bureau of Land & Water Resources

If well telescopes please sketch and show depths.

GROUND LEVEL

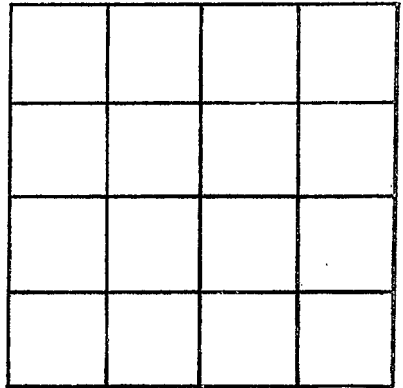

SECTION _____

Please indicate well location X.

ADDITIONAL INFORMATION

If more than one screen,
show locations of each on sketch.