

**MISSISSIPPI
BOARD OF WATER COMMISSIONERS**
416 North State Street
Jackson, Mississippi 39201

CODED

WATER WELL DRILLERS LOG

Yazoo
5
10-29-64
M.G.S.

10-29- 1964 Layne Central Co Yazoo
date well completed firm name county well located

LANDOWNER: Hally, Bluff
Water Association, Inc.
Hally Bluff, Miss
(mailing address)

description of formations encountered	from	to
<u>Clay</u>	<u>0</u>	<u>51</u>
<u>S.S.</u>	<u>51</u>	<u>114</u>
<u>Sand & Gravel</u>	<u>114</u>	<u>136</u>
<u>Brittle Clay</u>	<u>136</u>	<u>322</u>
<u>Fine Sand & Clay Sls</u>	<u>322</u>	<u>425</u>
<u>Fine Sand, Brk of Shale</u>	<u>425</u>	<u>475</u>
<u>Fine Sand, Sls of Hard Clay</u>	<u>475</u>	<u>650</u>
<u>Coar. S.S. & Clay</u>	<u>650</u>	<u>715</u>
<u>Hard Shale, Sls of Sand</u>	<u>715</u>	<u>805</u>
<u>Sandy Shale</u>	<u>805</u>	<u>894</u>
<u>Clay</u>	<u>894</u>	<u>915</u>
<u>Fine Sand & Shale Sls</u>	<u>915</u>	<u>1036</u>
<u>Coar. Sand</u>	<u>1036</u>	<u>1109</u>
<u>Clay</u>	<u>1109</u>	<u>1114</u>

WELL LOCATION:
sec. 9 T. 11 N R. 5
1 miles S of Hally Bluff
(distance) (direction) (nearest town)

WELL PURPOSE: Domestic
(home, irrigation, municipal, industrial)

WELL COMPLETION DATA:

- (1) diameter (inches) 8"
- (2) total depth (feet) 1114'
- (3) static water level (feet) 1' ^{below} above top of ground.
- (4) casing Steel, 313'6"
(material) (depth)
8" 771'3" of 4"
(size) If telescope see back.
- (5) screen 60'9",
(length) (depth to top)
4", St. Steel
(size) (material)
- (6) pump 20 200
(HP) (yield gpm)
Electric
(type power)
- (7) electric log Yes
(yes or no)
Miss. Geo Survey
(organization running log)
- (8) how well bottom plugged Valve

CODED


DRILLERS REMARKS:

DATE
APR 7 5 1965

MISS. Bd. OF
WATER COM.

If well telescopes please sketch and show depths.

GROUND LEVEL

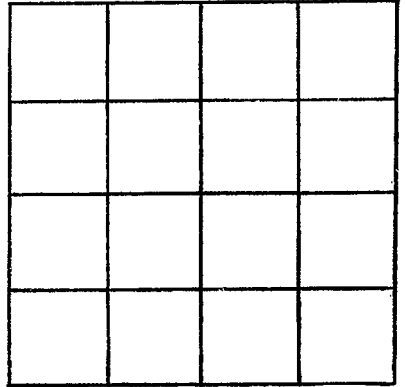

SECTION 9

Please indicate well location X.

ADDITIONAL INFORMATION

If more than one screen, show locations of each on sketch.