

Yazoo Co.

E Log # 210

No log in file

MISSISSIPPI BOARD OF WATER COMMISSIONERS
416 North State Street
Jackson, Mississippi 39201

WATER WELL DRILLERS LOG

217
CODED

~~_____~~
~~_____~~
10-10-69
M.G.S.

Oct 10 1969 date well completed
McConnell Drilling firm name
Sharkey county well located

LANDOWNER:
Obbie Lowery
Holly Bluff Miss.
(mailing address)

description of formations encountered	from	to
clay	0	33
sand & gravel	33	162
sandy shale & rock	162	304
sandy clay	304	1124
shale (sandy)	1124	204
sand shale & rock	204	776
& lots of lignite	776	920
Hard (broken)	920	1010
fine sand	1010	1054
Hard shale	1054	1123
sand	1123	1137
sandy shale		

WELL LOCATION:
sec. 6 T. 11 N. R. 5 SW
3 miles west of Holly Bluff
(distance) (direction) (nearest town)

WELL PURPOSE: Home
(home, irrigation, municipal, industrial)

WELL COMPLETION DATA:



- (1) diameter (inches) 4 X 2
- (2) total depth (feet) 1137'
- (3) static water level (feet) 8" below above top of ground.
- (4) casing Steel, 1137'
(material) (depth)
4 X 2 If telescopes see back.
(size)
- (5) screen 20', 1086'
(length) (depth to top)
2", stainless
(size) (material)
- (6) pump 1/2, 12
(HP) (yield gpm)
Elect.
(type power)
- (7) electric log MS
(yes or no)
MS
(organization running log)
- (8) how well bottom plugged, back wash valve.

OCT 14 1969
MISS. BD. OF WATER COMM.

DRILLERS REMARKS:

If well telescopes please sketch and show depths.

GROUND LEVEL

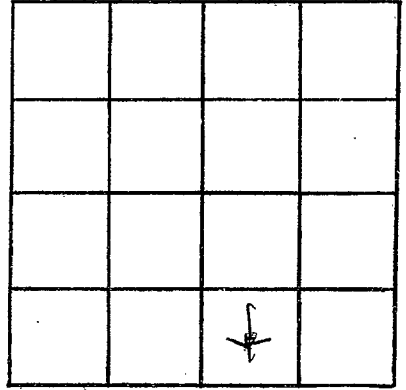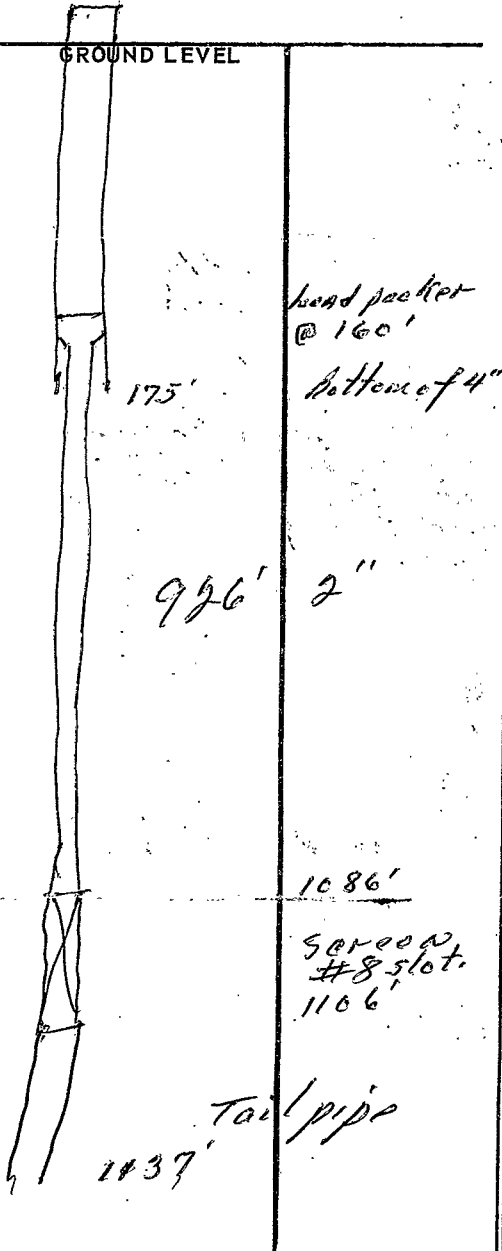

SECTION 1

Please indicate well location X.

ADDITIONAL INFORMATION

If more than one screen, show locations of each on sketch.