

YA200  
J7  
6-8-71

MISSISSIPPI  
BOARD OF WATER COMMISSIONERS  
416 North State Street  
Jackson, Mississippi 39201

**CODED**

WATER WELL DRILLERS LOG

June 8 1971 E.M. "Bud" Crosswell Yazoo  
Date well completed firm name county well located

LANDOWNER:

Donald P. Sibley  
Holly Bluff, Miss.  
(mailing address)

description of formations encountered

from to

Clay 0 10  
Sand-gravel 10 89

WELL LOCATION:

sec. 6 T. 14 N R. 5 E  
2 miles North of Holly Bluff  
(distance) (direction) (nearest town)

WELL PURPOSE: Home  
(home, irrigation, municipal, industrial)

WELL COMPLETION DATA:

- (1) diameter (inches) 2
- (2) total depth (feet) 89
- (3) static water level (feet) 25 below top of ground.
- (4) casing Steel 84  
(material) (depth)  
2 (size) if telescope see back.
- (5) screen 5 84  
(length) (depth to top)  
2" stainless  
(size) (material)
- (6) pump none  
(HP) (yield gpm)  
0 (type power)
- (7) electric log No  
(yes or no)  
0 (organization running log)

**CODED**

(8) how well bottom plugged  
Steel plug

DRILLERS REMARKS:


JUL 16 1971

MISS. DEP.  
WATER

If well telescopes please sketch and show depths.

---

**GROUND LEVEL**

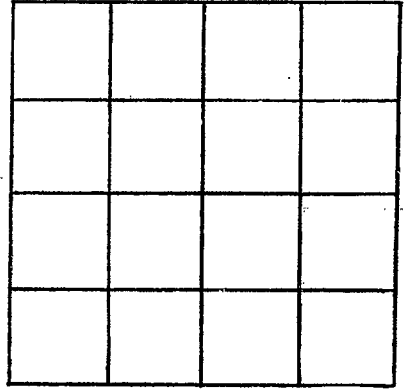

**SECTION \_\_\_\_\_**

Please indicate well location X.

**ADDITIONAL INFORMATION**

---



---



If more than one screen, show locations of each on sketch.