

CODED

MISSISSIPPI
BOARD OF WATER COMMISSIONERS
416 North State Street
Jackson, Mississippi 39201

CODED

WATER WELL DRILLERS LOG *Perd. 8/70*

YAZOO
J-8
5-6-71

5-6 1971 McConnell Drill Yazoo
date well completed firm name county well located

LANDOWNER:
L.K. Waller
Holly Bluff Miss.
(mailing address)

description of formations encountered	from	to
	0	18
Top Soil & Clay	18	143
Sand & Gravel	18	143
hard clay	143	200
Sand, lig. clay.	200	360
Sand.	360	686
shale, Rock & Sandy	686	789
Sand (fine)	789	828
hard shale.	828	930
Fine Sand.	930	941
hard shale (st of sand)	941	1200
SAND	1200	1390

WELL LOCATION:
sec. 10 T. 11 N. R. 5 E
W
1 1/2 miles E of Holly Bluff
(distance) (direction) (nearest town)

WELL PURPOSE: home
(home, irrigation, municipal, industrial)

WELL COMPLETION DATA:

- (1) diameter (inches) 4x2
- (2) total depth (feet) 1280
- (3) static water level (feet) 1' below above-top of ground.
- (4) casing Steel, 1280'
(material) (depth)
4x2 if telescope see back.
(size)
- (5) screen 20', 1220
(length) (depth to top)
2", 3.5'
(size) (material)
- (6) pump 3/4, 20
(HP) (yield gpm)
Elect.
(type power)
- (7) electric log NO
(yes or no)

(organization running log)

(8) how well bottom plugged
Back Wash Valve

DRILLERS REMARKS:

CODED

MAY 18 1971

MISS. BD. OF
WATER COM.

If well telescopes please sketch and show depths.

GROUND LEVEL

160' 4"


Lead Seal

1056' 2"

20' Johnson S.S.

44' Tail Pipe

If more than one screen,
show locations of each on sketch.

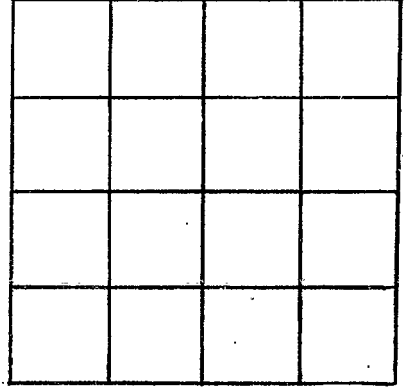

SECTION _____

Please indicate well location X.

ADDITIONAL INFORMATION

A series of horizontal lines for providing additional information.