

YAZOO
 J14
 10/31/79

MISSISSIPPI
 BOARD OF WATER COMMISSIONERS
 416 North State Street
 Jackson, Mississippi 39201

CODED

WATER WELL DRILLERS LOG

Oct. 31 1979
 date well completed

E.M. "Bud" CRESSWELL
 firm name

YAZOO
 county well located

LANDOWNER:
 Roy Stricklin
 Yazoo City, Ms.
 (mailing address)

description of formations encountered	from	to
Clay	0	20
Dark gray sand	20	130
clay	130	240
Sandy shale	240	320
Sand	320	580
Shale	580	760
Sandy shale	760	840
Sand	840	940

WELL LOCATION:
 sec 36 T 11 N R 4 E
 6 miles South of Yazoo
 (distance) (direction) (nearest town)

WELL PURPOSE: Home
 (home, irrigation, municipal, industrial)

WELL COMPLETION DATA:
 (1) diameter (inches) 4 x 2
 (2) total depth (feet) 940
 (3) static water level (feet) 10 below top of ground.
 (4) casing steel 910 (material) (depth)
 4 (size) if telescope see back.
 (5) screen 30 910 (length) (depth to top)
 7 stainless (size) (material)
 (6) pump 1 30 (HP) (yield gpm)
 0 (type power)
 (7) electric log no (yes or no)
 0 (organization running log)

(8) how well bottom plugged
 steel plug

DRILLERS REMARKS:


DEPT. OF NATURAL RESOURCES
 BUREAU OF LAND & WATER RESOURCES

NOV - 6 1979

RECEIVED

If well telescopes please sketch and show depths.

GROUND LEVEL

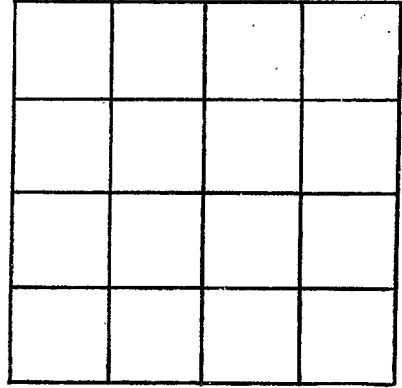

SECTION _____

Please indicate well location X.

ADDITIONAL INFORMATION

If more than one screen, show locations of each on sketch.