

MISSISSIPPI DEPARTMENT OF NATURAL RESOURCES

Bureau of Land and Water Resources

Southport Mall

P.O. Box 10631

Jackson, Mississippi 39209

WATER WELL DRILLERS LOG

Jazoo
515
3-25-81

March 25 1981 Larry Well & Pump Jazoo
date well completed firm name county well located

LANDOWNER: William Davis
Holly Bluff, Miss
(mailing address)

description of formations encountered	CODED	
	from	to
CLAY	0	50
FINE SAND	50	75
MED. SAND	75	90
COURSE SAND	90	130


WELL LOCATION:
sec. 15 T 11 N R. 5 W
4 miles South of Holly Bluff
(distance) (direction) (nearest town)

WELL PURPOSE:
(home, irrigation, municipal, industrial)

- WELL COMPLETION DATA:
- (1) diameter (inches) 16"
 - (2) total depth (feet) 130'
 - (3) static water level (feet) 18 below above top of ground.
 - (4) casing Steel 90'
(material) (depth)
(size) if telescope see back.
 - (5) screen 40' 90'
(length) (depth to top)
16" Steel
(size) (material)
 - (6) pump 60 3000
(HP) (yield gpm)
(type power)
 - (7) electric log No
(yes or no)
(organization running log)
 - (8) how well bottom plugged Steel Plate


DRILLERS REMARKS:

CODED

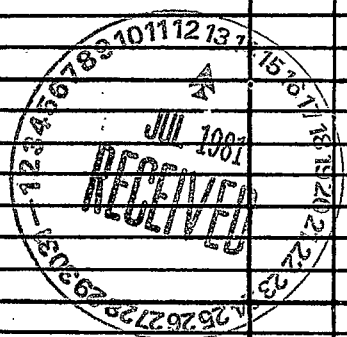

If well telescopes please sketch and show depths.

GROUND LEVEL

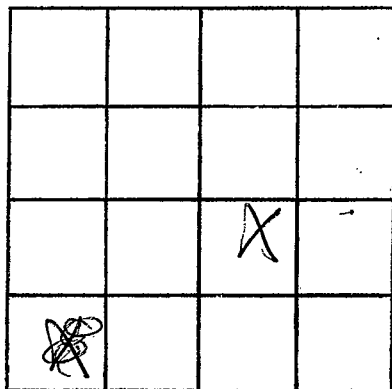

SECTION ¹⁵~~25~~

Please indicate well location X.

ADDITIONAL INFORMATION

If more than one screen, show locations of each on sketch.