

MISSISSIPPI DEPARTMENT OF NATURAL RESOURCES

Bureau of Land and Water Resources

Southport Mall

P.O. Box 10631

Jackson, Mississippi 39209

WATER WELL DRILLERS LOG

CODED

Yazoo
J 16
11-19-81

11-19 1981 date well completed
Dyer Well + Irrigation firm name
Yazoo county well located


LANDOWNER: <u>Hickman</u> <u>HEGMAN</u>	description of formations encountered	from	to
<u>Holly Bluff</u> (mailing address)	<u>Clay</u>	<u>0</u>	<u>10</u>
WELL LOCATION: sec. <u>22</u> T. <u>11</u> N. R. <u>5</u> E <u>3</u> miles <u>S</u> of <u>Holly Bluff</u> (distance) (direction) (nearest town)	<u>Fine Sand</u>	<u>10</u>	<u>35</u>
WELL PURPOSE: <u>Irrigation</u> (home, irrigation, municipal, industrial)	<u>Clay</u>	<u>35</u>	<u>55</u>
WELL COMPLETION DATA: (1) diameter (inches) <u>12 3/4"</u>	<u>Sand + Gravel</u>	<u>55</u>	<u>103</u>
(2) total depth (feet) <u>103</u>			
(3) static water level (feet) <u>20'</u> below top of ground.			
(4) casing <u>Steel</u> , <u>63</u> , (material) (depth), <u>12 3/4</u> if telescope see back. (size)			
(5) screen <u>40'</u> , <u>63</u> (length) (depth to top) <u>12"</u> , <u>Steel</u> (size) (material)			
(6) pump <u>60</u> <u>900</u> (HP) (yield gpm) <u>Diesel</u> (type power)			
(7) electric log <u>No</u> (yes or no) (organization running log)			
(8) how well bottom plugged <u>Plate</u>			
DRILLERS REMARKS:			

RECEIVED
DEC 10 1981
BUREAU OF LAND & WATER RESOURCES

DEPT. OF NATURAL RESOURCES
BUREAU OF LAND & WATER RESOURCES
DEC 10 1981
RECEIVED

If well telescopes please sketch and show depths.

GROUND LEVEL

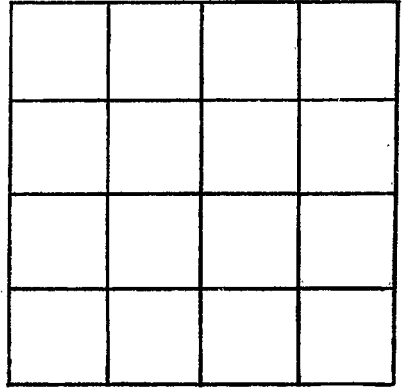

SECTION _____

Please indicate well location X.

ADDITIONAL INFORMATION

If more than one screen,
show locations of each on sketch.