

MISSISSIPPI DEPARTMENT OF NATURAL RESOURCES

Bureau of Land and Water Resources

Southport Mall

P.O. Box 10631

Jackson, Mississippi 39209

WATER WELL DRILLERS LOG **CODED**

187
Griner Drilling Service, Inc.

Vazoo

YAZOO
J 17
8-16-82

8-16-82 date well completed

firm name

county well located

LANDOWNER:
Rapad Drilling
P.O. Box 447
Laurel, Ms. 39401
(mailing address)

description of formations encountered	from	to
<i>chalk</i>	<i>0</i>	<i>21'</i>
<i>chalk + sand</i>	<i>21'</i>	<i>42'</i>
<i>sand + pea gravel</i>	<i>42'</i>	<i>126'</i>
<i>sand + pea gravel</i>	<i>126'</i>	<i>147'</i>
<i>rock, chalk</i>		
<i>chalk</i>	<i>147'</i>	<i>210'</i>

WELL LOCATION: *2043'S + 2115'E*
sec. *5* T. *11* N. R. *5* E NW/4
1 Holly Bluff
(distance) (direction) of (nearest town)

WELL PURPOSE: *oil field supply*
(home, irrigation, municipal, industrial)

- WELL COMPLETION DATA:
- (1) diameter (inches) *3"*
 - (2) total depth (feet) *210'*
 - (3) static water level (feet) *20'* **below** top of ground. **above**
 - (4) casing *steel*, *126'*
(material) (depth)
 - 3"*
(size) If telescope see back.
 - (5) screen *42'*, *84'*
(length) (depth to top)
 - 3"*, *perforated*
(size) (material)
 - (6) pump *—*, *75*
(HP) (yield gpm)
 - AC*
(type power)
 - (7) electric log *—*
(yes or no)
 - (organization running log)
 - (8) how well bottom plugged *orange peel*

CODED

32495309044-10

Elevation *92'*


DEPT. OF NATURAL RESOURCES
BUREAU OF LAND & WATER RESOURCES

AUG 18 1982
RECEIVED

DRILLERS REMARKS:

If well telescopes please sketch and show depths.

GROUND LEVEL

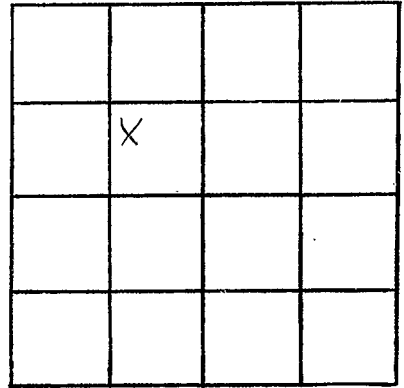

SECTION _____

Please indicate well location X.

ADDITIONAL INFORMATION

If more than one screen,
show locations of each on sketch.