

MISSISSIPPI DEPARTMENT OF NATURAL RESOURCES

Bureau of Land and Water Resources

Southport Mall

P.O. Box 10631

Jackson, Mississippi 39209

WATER WELL DRILLERS LOG

YAZOO  
J 18  
3/12/83

3-12-83 date well completed

Ingram Drilling Service, Inc. firm name

Yazoo county well located

LANDOWNER:

O.S.L. Energy  
P.O. Box 402405  
Dallas, Texas 75240  
(mailing address)

description of formations encountered

from

to

clay	0	35
sand, gravel	35	130
clay	130	182

WELL LOCATION: 1418°54'1375"E

sec. 16 T. 11 N. R. 4 E. NW 1/4

no. 166  
Bogalusa (direction) of (nearest town)

WELL PURPOSE: oil field support  
(home, irrigation, municipal, industrial)

WELL COMPLETION DATA:

- (1) diameter (inches) 3"
- (2) total depth (feet) 182'
- (3) static water level (feet) 20' <sup>below</sup> above top of ground.
- (4) casing steel, 135'  
(material) (depth)  
3"  
(size) If telescope see back.
- (5) screen 42', 93'  
(length) (depth to top)  
3" perforated  
(size) (material)
- (6) pump —, 70  
(HP) (yield gpm)  
AC  
(type power)
- (7) electric log —  
(yes or no)  
—  
(organization running log)

CODED

(8) how well bottom plugged orange  
peel

DRILLERS REMARKS:


DEPT. OF NATURAL RESOURCES  
BUREAU OF LAND & WATER RESOURCES

APR 20 1983

RECEIVED

If well telescopes please sketch and show depths.

GROUND LEVEL

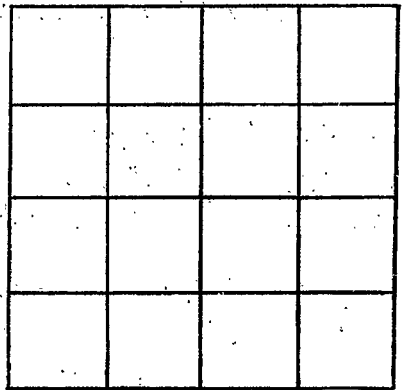

SECTION \_\_\_\_\_

Please indicate well location X.

ADDITIONAL INFORMATION

If more than one screen, show locations of each on sketch.