

MISSISSIPPI DEPARTMENT OF NATURAL RESOURCES

Bureau of Land and Water Resources

Southport Mall

P.O. Box 10631

**CODED**

Jackson, Mississippi 39209

**WATER WELL DRILLERS LOG**

J19 ELOG #297  
 YAZOO  
 3-13-84

Mar. 13 19 84 Bruce Berryman - Yazoo  
 date well completed firm name county well located  
 Greenwood, MS

LANDOWNER: Mrs. Bruce Dent.

P.O. Box 657,  
 Yazoo City, MS 39194

(mailing address)

WELL LOCATION:

sec. 31 T. 11N R. 4E  
 S W  
 12 miles SW of Yazoo City  
 (distance) (direction) (nearest town)

WELL PURPOSE: Home & farm  
 (home, irrigation, municipal, industrial)

WELL COMPLETION DATA:

- (1) diameter (inches) 4" x 2"
- (2) total depth (feet) 1220'
- (3) static water level (feet) 20' below top of ground.
- (4) casing 4" blk. - 126' (material) 2" galv. - 1074' (depth)

if telescope see back.  
 (size)

- (5) screen 20' 1200'  
 (length) (depth to top)

2" .010 ga. Stainless steel  
 (size) (material)

- (6) pump 3 h.p. 50  
 (HP) (yield gpm)

Electric  
 (type power)

- (7) electric log Yes  
 (yes or no)

MS Bureau of Geology  
 (organization running log)

- (8) how well bottom plugged B.P.V.

DRILLERS REMARKS:

description of formations encountered	from	to
Clay	0	20
Fine sand	20	60
Sand & little gravel	60	100
Clay	100	200
Sandy clay	200	220
Sand	220	280
Clay	280	290
Sand	290	400
Shale	400	440
Sand	440	460
Shale	460	700
Shale & rock	700	740
Shale	740	840
Shale & rock	840	860
Shale	860	880
Sandy shale	880	980
Shale	980	1120
Fine hard sand	1120	1160
Sand	1160	1240


DEPT. OF NATURAL RESOURCES  
 BUREAU OF LAND & WATER RESOURCES

JUL 31 1984

**RECEIVED**

If well telescopes please  
sketch and show depths.

GROUND LEVEL

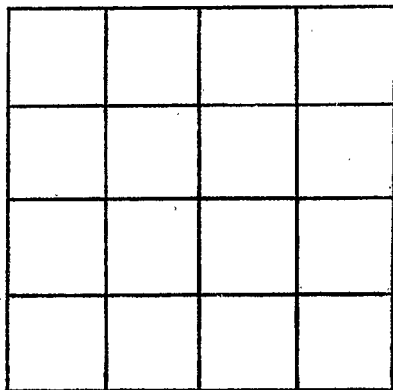

SECTION \_\_\_\_\_

Please indicate well location X.

ADDITIONAL INFORMATION

If more than one screen,  
show locations of each on sketch.