

MISSISSIPPI DEPARTMENT OF NATURAL RESOURCES

Bureau of Land and Water Resources

Southport Mall

P.O. Box 10631

Jackson, Mississippi 39209

WATER WELL DRILLERS LOG

CODED

John Patton Chism

Y2200
J20
4/12/82

April 12, 1982
date well completed

Organization Equipment, Inc.
firm name

Yazoo
county well located

LANDOWNER:	description of formations encountered	from	to
Verditt Boyd	Clay	0	30'
	Fine Sand	30'	47'
	Coarse Sand	47'	66'
(mailing address)	Coarse Sand	66'	110'
WELL LOCATION:			
sec. <u>22</u> T. <u>11</u> <u>N</u> R. <u>5</u> <u>E</u> S W			
<u>2 1/2</u> miles South of <u>Holly Bluff</u> (distance) (direction) (nearest town)			
WELL PURPOSE: <u>irrigation</u> (home, irrigation, municipal, industrial)			
WELL COMPLETION DATA:			
CODED			
(1) diameter (inches)	<u>12"</u>		
(2) total depth (feet)	<u>106'</u>		
(3) static water level (feet)	<u>24'</u> <u>below</u> top of ground. above		
(4) casing	<u>Steel</u> , <u>106'</u> (material) (depth)		
	<u> </u> if telescope see back. (size)		
(5) screen	<u>40'</u> , <u>66'</u> (length) (depth to top)		
	<u>12"</u> <u>Steel</u> (size) (material)		
(6) pump	<u>60</u> , <u>1300</u> (HP) (yield gpm)		
	<u>Diesel</u> (type power)		
(7) electric log	<u> </u> (yes or no)		
	<u> </u> (organization running log)		
(8) how well bottom plugged	<u>steel plate</u>		
DRILLERS REMARKS:			


DEPT. OF NATURAL RESOURCES
BUREAU OF LAND & WATER RESOURCES

MAY - 3 1982

RECEIVED

If well telescopes please sketch and show depths.

GROUND LEVEL

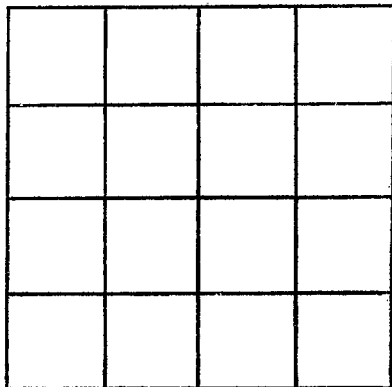

SECTION _____

Please indicate well location X.

ADDITIONAL INFORMATION

If more than one screen,
show locations of each on sketch.