

MISSISSIPPI DEPARTMENT OF NATURAL RESOURCES

Bureau of Land and Water Resources

Southport Mall

P.O. Box 10631

Jackson, Mississippi 39209

WATER WELL DRILLERS LOG

CODED

Yazoo
J21
4/17/82

John Patton Chesno
~~IRRIGATION EQUIPMENT, INC.~~

4/17/82

date well completed

19

firm name

YAZOO

county well located

LANDOWNER: <u>Verditt Boyd</u>	description of fomations encountered	from	to
	Fine Sand	34'	50'
	Coarse Sand	50'	65'
(mailing address)	Coarse sand/small gravel	65'	102'
WELL LOCATION: sec. <u>22</u> T <u>11</u> N R <u>5</u> E <u>2 1/2</u> miles South HollyBluff (distance) (direction) of (nearest town)			
WELL PURPOSE: <u>Irrigation</u> (home, Irrigation, municipal, industrial)			
WELL COMPLETION DATA:			
(1) diameter (inches) <u>12"</u>			
(2) total depth (feet) <u>102'</u>			
(3) static water level (feet) <u>23'</u> <u>below</u> above top of ground.			
(4) casing <u>steel</u> , <u>102'</u> (material) (depth) <u> </u> if telescope see back. (size)			
(5) screen <u>40'</u> <u>62'</u> (length) (depth to top) <u>12"</u> <u>steel</u> (size) (material)			
(6) pump <u>60</u> <u>1300</u> (HP) (yield gpm) <u>Wiesel</u> (type power)			
(7) electric log <u> </u> (yes or no) <u> </u> (organization running log)			
(8) how well bottom plugged <u>steel plat</u>			
DRILLERS REMARKS:			

CODED


DEPT. OF NATURAL RESOURCES
BUREAU OF LAND & WATER RESOURCES

MAY - 3 1982

RECEIVED

If well telescopes please sketch and show depths.

GROUND LEVEL

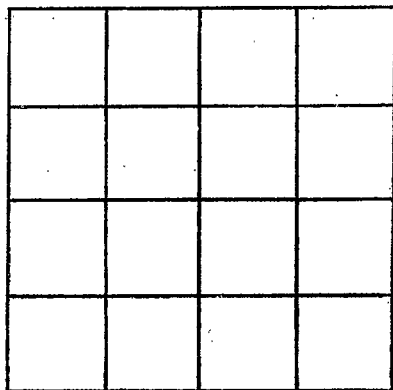

SECTION _____

Please indicate well location X.

ADDITIONAL INFORMATION

If more than one screen,
show locations of each on sketch.