

MISSISSIPPI DEPARTMENT OF NATURAL RESOURCES

Bureau of Land and Water Resources

Southport Mall

P.O. Box 10631

Jackson, Mississippi 39209

WATER WELL DRILLERS LOG

CODEL

Yazoo
J 22
5-21-82

May 21 19 82 South Delta Yazoo
date well completed firm name county well located

LANDOWNER:	description of formations encountered	from	to
Nabors (Hogue) Yazoo City, MS (mailing address)			
WELL LOCATION:	fine sand	15	40
sec. 35 T 11 N S R 4 E W	medium sand	40	70
6 miles NW of Sartoria (distance) (direction) (nearest town)	fine sand & clay	70	80
WELL PURPOSE: (home, irrigation, municipal, industrial)	course sand	80	100
WELL COMPLETION DATA:	gravel	100	110
(1) diameter (inches) 16	clay	110	112
(2) total depth (feet) 110			
(3) static water level (feet) 20' below top of ground.			
(4) casing 16" (material), 70' (depth)			
16" (size) if telescope see back.			
(5) screen 40' (length), 70' (depth to top)			
16" (size), steel (material)			
(6) pump 60 (HP), 3000 (yield gpm)			
Propane (type power)			
(7) electric log NO (yes or no)			
(organization running log)			
(8) how well bottom plugged plate			
DRILLERS REMARKS:			

CODED


DEPT. OF NATURAL RESOURCES
BUREAU OF LAND & WATER RESOURCES

SEP 28 1982
RECEIVED

6

If well telescopes please sketch and show depths.

GROUND LEVEL

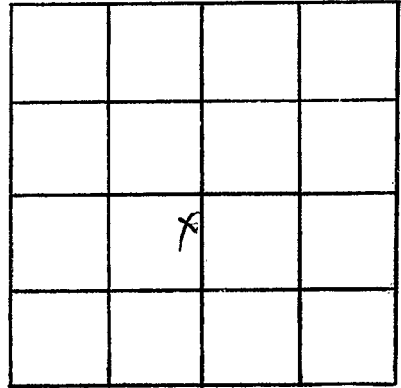

SECTION 35

Please indicate well location X.

ADDITIONAL INFORMATION

If more than one screen,
show locations of each on sketch.