

MISSISSIPPI DEPARTMENT OF NATURAL RESOURCES

Bureau of Land and Water Resources

Southport Mall

P.O. Box 10631

Jackson, Mississippi 39209

WATER WELL DRILLERS LOG

CODED

Yazoo
J 23
7-22-82

date well completed July 22 19 82 firm name South Delta county well located Yazoo

LANDOWNER:	description of formations encountered	from	to
<u>F. Saxton</u>			
<u>Yazoo City, MS.</u> (mailing address)	<u>Coarse sand</u>	<u>10</u>	<u>40</u>
WELL LOCATION:	<u>Medium sand</u>	<u>40</u>	<u>60</u>
sec. <u>32</u> T. <u>11</u> (N) S R. <u>4</u> (W) E	<u>Coarse sand w/ gravel</u>	<u>60</u>	<u>103</u>
<u>5</u> miles <u>SE</u> of <u>Holly Bluff</u> (distance) (direction) (nearest town)			
WELL PURPOSE: (home, irrigation, municipal, industrial)			
WELL COMPLETION DATA:			
(1) diameter (inches) <u>16"</u>			
(2) total depth (feet) <u>103'</u>			
(3) static water level (feet) <u>19'</u> below above top of ground.			
(4) casing <u>Steel</u> <u>63'</u> (material) (depth)			
<u>16"</u> (size) if telescope see back.			
(5) screen <u>40'</u> <u>63'</u> (length) (depth to top)			
<u>16"</u> <u>Steel</u> (size) (material)			
(6) pump <u>40</u> <u>2000</u> (HP) (yield gpm)			
<u>Diesel</u> (type power)			
(7) electric log <u>NO</u> (yes or no)			
(organization running log)			
(8) how well bottom plugged <u>plate</u>			
DRILLERS REMARKS:			

CODED

DEPT OF NATURAL RESOURCES
 BUREAU OF LAND & WATER RESOURCES


SEP - 8 1982

RECEIVED

8

If well telescopes please sketch and show depths.

GROUND LEVEL

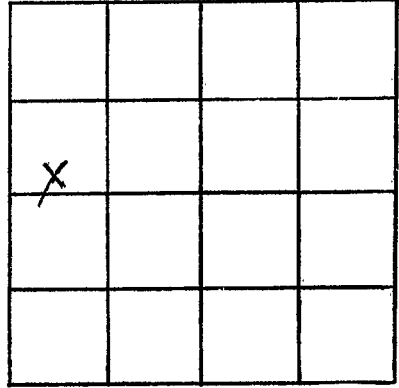

SECTION 32

Please indicate well location X.

ADDITIONAL INFORMATION

A series of horizontal lines for writing additional information, starting below the 'ADDITIONAL INFORMATION' header and extending to the bottom of the page.

If more than one screen, show locations of each on sketch.