

MISSISSIPPI DEPARTMENT OF ENVIRONMENTAL QUALITY
Bureau of Land and Water Resources

P. O. Box 10631
Jackson, MS 39289-0631
WATER WELL DRILLERS LOG

COUNTY WELL LOCATED YAZZO	WELL NUMBER II J26	CODED	PERMIT NUMBER
DATE WELL COMPLETED 4-16-92			NAME OF DRILLING FIRM CBS Drillers

NAME & MAILING ADDRESS OF LANDOWNER
Elken Morrow FARMS

RT. 4, Box 308

YAZZO, MS. 39194

WELL LOCATION: SEC **25** TOWNSHIP **11 N** RANGE **4**

DISTANCE **10** Miles **W** of **YAZZO CITY**

OTHER LANDMARK

WELL PURPOSE: Home, Irrigation, Municipal, Industrial, Fish Pond, etc

PUMP DATA

PUMP TYPE (Circle One):
Submersible Turbine, Jet, Flowing Well,
Other (Describe)

POWER TYPE (Circle One):
Electric, Tractor, Diesel, Gasoline, Butane,
Other (Describe) H/P **5**

Pump Capacity (GPM) 80	No. of Stages 15	Setting Depth 189 FT.
----------------------------------	----------------------------	---------------------------------

PUMP TEST

Well yielded **100** GPM with
a drawdown of **42** ft.
after **8** hours of pumping

WELL DATA

Well Depth 562	Casing Diameter (In.) 4	Casing Length (Ft.) 512
Type of Casing PVC	Hole Depth 574	Depth to Static Water Level 11

TYPE OF COMPLETION: (Circle One or More):
Natural Development, Gravel Packed, Underreamed, Telescoped,
Open Hole, Other

Top of Lap Pipe or Reduction in Casing

FEET IF TELESCOPED OR MORE THAN ONE SCREEN: USE BACK PAGE

LOG DATA

TYPE OF LOG RUN (Circle One):
Electric, Gamma Ray, Density, Sonic, Neutron,
Other (Describe)

Name of Organization Running Log

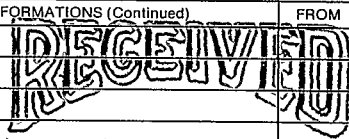
SCREEN DATA

Diameter - Inches 4	Length - Feet 50	Slot Size - Inches 10/10
Screen Type PVC	Depth to Bottom - Feet 562	

GEOLOGIC DATA (Office Use Only)

Surface Elev.	Geologic Unit	Unit Thickness	Depth to Top
Subs. SWL	Date	Analysis	Aquifer Test

Driller's Remarks

DESCRIPTION OF FORMATIONS ENCOUNTERED	FROM	TO	FORMATIONS (Continued)	FROM	TO
TOP Soil & clay	0	19	 MAY 27 1992 Dept. of Environmental Quality Bureau of Land & Water Resources		
Sand	19	69			
Sand & Gravel	69	144			
Clay	144	331			
Sand & ST. Clay	331	408			
Sand	408	451			
Clay	451	490			
Sand	490	574			

IF MORE SPACE IS NEEDED, USE BACK

If well telescopes please
sketch and show depths.

GROUND LEVEL

		2	

SECTION 25

Please indicate well location X.

ADDITIONAL INFORMATION

If more than one screen,
show location of each on sketch.