County: _	Yazo	0
Permit #: Irri	GW gation	40473 Equipment
Driller: _		6-23-05

State Well Report

Part 1

Mississippi Department of Environmental Quality
Office of Land and Water Resources
P.O. Box 10631
Jackson, MS 39289-0631
(601)961-5210
(601)354-6938 (fax)

For Office Use Only:	
Aquifer:	
Well #:	J- 133
L. S. Ele	vation:
E-log#:	

State Law requires that this report be prepared by the driller in detail and filed with the Department within 30 days of completion of drilling of the well


30 days of completion of drilling of the well.				
Well Owner Information	Well Location			
Owner Name Clay Adcock	Latitude: 32 . 46 ,57 . 1 Longitude: 90 .42 ,4			
Mailing Address: Box 159	Method of Lat/Long (circle one): Conventional Survey,			
	WSGS quad, Hand-held GPS, Survey-grade GPS			
	W 1/2 5 1/2 Sec 27 Twn 11N Rng 5W			
Holly Bluff, MS 39088	74 / 74 Sec 27 IWI 1 1 IV RING SW			
City State Zip Code	Distance Direction Nearest Town			
Telephone No. ()	3 Miles South of Holly Bluff			
Well	Date			
Purpose of Well (circle one) Home Industrial Public Supply	Pivot Irrigation Fish Culture Other: eplacement			
Date well drilling started: 6-23-05 Date	well drilling completed: 6-23-05			
If flowing, method of flow regulation: Valve Other (c	lescribe)			
Static Water Level:19'feet above of below (circle one)				
Method of Measurement (circle one) teel tape electric tape	air line other:			
Hole depth: 127' Well depth: 127' Well grouted to a depth of 10 feet				
Type of grout (circle one): Cement Bentonite Mix	· ·			
Casing length: 97 feet Casing diameter. 16	inches Type of casing: PVC Sch. 40			
Screen length: 30 feet Screen diameter: 16	inches Type of screen: PVC Sch 40			
Screen slot size:050 inches Setting depth: From98feet to127feet				
Type of completion (circle all applicable): Gavel packed Underreamed Telescoped Open hole Natural Development				
Other (describe):				
Top of lap pipe or reduction in casing: feet. If telescoped or more than one screen, describe on back of page				
Logs run (circle all applicable): No log run Electric Gamma Ray Density Sonic Neutron Other:				
Name of organization running log(s):				
I certify that the well was drilled, constructed, and completed in accordance with all applicable requirements of the Mississippi				
Department of Environmental Quality and/or the Mississippi Department of Health regulations and state laws.				
Irrigation Equipment Inc. Patrick M. Chism 0695				
Print Name of Water Well Contractor and License No.	Signature of Water Well Contractor			

Ground Level

Description of Formations Encountered	From	To
Clay	0	15
Fine Sand Med. Sand/gravel	16	95
Med. Sand/gravel	96	127
	1	
		\vdash
	1	
	+	1
	+	+-+
	+	+
	-	 -
		1
		1
	1	<u> </u>
		\vdash
<u> </u>	+	+-1
	+	+
	+	┼
		├ ──┤
		\perp
		\perp

If more than one screen, show location of each on sketch

Sketch the property layout and include the following: 1) the well location; 2) any permanent structures on the property that may aid in locating the well; 3) any roads, power lines, or other items that may aid in locating the property and the well; 4) indicate direction.

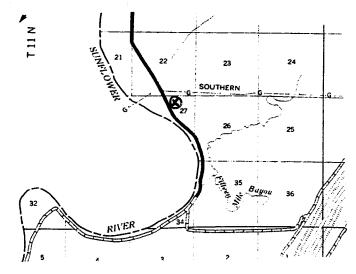

Landowner Name:

Signature of Water Well Contractor

STATE WELL REPORT

Part 2

Permit #: 40473

Irrigation Equipment
Driller:

6-25-05

Pump Installer's Completion Report
Mississippi Department of Environmental Quality
Office of Land and Water Resources
P.O. Box 10631
Jackson, MS 39289-0631
(601)961-5210

For Office Use Only:			
Aquifer:			
Well #:	J-133		
Elevation	ı:		

Date completed: $\frac{6-25-05}{}$ (6)	(601)961-5210 01)354-6938 (fax) Elevation:			
This report should be prepared by the pump installer in detail and filed with the Department within 30 days of the installation of pump.				
Well Owner Information	Well Location			
Owner Name: Clay Adcock	Latitude: Longitude:			
Mailing Address: BOX 159	Method of Lat/Long (circle one): Conventional Survey,			
	USGS quad, Hand-held GPS, Survey-grade GPS			
Holly Bluff, MS 39088	NU 1/2 W 1/2 Sec 27 7 Twn 11 NRng 5W			
City State Zip Code	Distance Direction Nearest Town			
Telephone No. ()	3 Miles South of Holly Bluff			
Pump Type Circle one	Power Type Circle one			
Air Lift Jet Submersible	Diesel Engine Gasoline Engine Natural Gas			
Bucket Piston Turbine	Electric Motor Hand Tractor PTO			
Centrifugal Rotary Flowing Well	Windmill Other (specify):			
Other (specify):	Horse Power Rating of Motor: 60			
Date Pump Installed: 6-25-05	Setting Depth:			
Rated Pump Capacity: Gallons Per Minute	Number of Stages: 3			
Pump Test Data	Method of Measuring Water Level Circle one			
Date Well Tested:	Air View Plantis Managine View Good Trans			
Static Water Level (A):Feet Below Land Surfac				
Pumping Water Level (B):Feet Below Land Surface	Other (specify):			
Drawdown [(B) - (A)]:Feet Below Land Surface	For flowing well, measured shut in head:feet			
Test Pumping Rate:Gallons Per Minute	Well yieldedGPM with a drawdown of			
Duration of Pump Test (minimum 4 hours):hours	feet afterhours of pumping			
I HEREBY CERTIFY that the above statements are true to the best of my movieded. Patrick M. Chism 0695 Print Name of Pump Installer and License No. (if applicable) Signature of Pump Installer				