

YA200

J 200

7-15-63

WATER WELL DRILLERS LOG

Date: 7-15, 19 63 Driller: CREEL (Name) CRESSID County YB200

(1) Owner of Land: B. (Name) PARKER
H L L Y B L (Address) F, MISS.

(2) Location: 1/4, 1/4, Sec. 18 T. R 5
1 miles (distance) of MISSISSIPPI (direction) (Nearest Town)

(3) Topography: (Hilly) Low (Flat) Low (Level)

(4) Purpose of Well: Domestic Irrigation
 Municipal, Industrial, Other

Description & Color of Materials Sand, Clay, Red Clay, Shell, etc.	Thick- ness Feet	Depth Feet
<u>20' SAND AND GRAVEL</u>	<u>20</u>	<u>20</u>
<u>6' COMB</u>	<u>50</u>	<u>200</u>
<u>4' RED M. S. SAND</u>	<u>40</u>	<u>340</u>
<u>4' GRAY SHALE</u>	<u>80</u>	<u>320</u>
<u>5' STR. FINE SAND</u>	<u>60</u>	<u>380</u>
<u>4' GRAY SAND</u>	<u>60</u>	<u>440</u>
<u>1' SAND AND SHALE</u>	<u>60</u>	<u>500</u>
<u>BROWN SHALE</u>		
<u>5' STR. FINE SAND</u>		
<u>with HARD ROCK</u>	<u>580</u>	<u>1000</u>
<u>BROWN COMB</u>		
<u>with STR. ROCK</u>	<u>50</u>	<u>1050</u>
<u>SAND GOOD</u>	<u>1180</u>	<u>1160</u>

Information upon completion of well:

(1) Diameter 4 1/2 inches.

(2) Total Depth 1168 feet.

(3) Water Level 4 feet below top of ground.

(4) Cased to 1188, Size 4 1/2.


(5) Screen: Size 2, Length 30.

(6) Were any formations sealed against pollution?
yes, no.

If YES depth of formation _____

Why _____

Drillers Remarks: _____

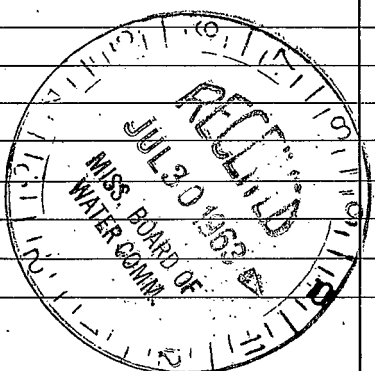

(Use Back Side)

Well No.

