

YAZOO
 J 2002
 4-26-78

MISSISSIPPI
 BOARD OF WATER COMMISSIONERS
 416 North State Street
 Jackson, Mississippi 39201

WATER WELL DRILLERS LOG


4-26 date well completed 78 E.M. "Bud" Cresswell firm name YAZOO county well located

LANDOWNER:	description of formations encountered	from	to
Panther Creek Farms			
YAZOO City, MS. (mailing address)	Clay Sand/gravel	0 15	15 85
WELL LOCATION:			
sec. 16 T 11 N R 4 W 8 miles N.W. of SATALFA (distance) (direction) (nearest town)			
WELL PURPOSE: Farm (home, irrigation, municipal, industrial)			
WELL COMPLETION DATA:			
(1) diameter (inches) 2			
(2) total depth (feet) 85			
(3) static water level (feet) 10 below top of ground.			
(4) casing PVC 80 (material) (depth)			
2 (size) if telescope see back.			
(5) screen 5 80 (length) (depth to top)			
2 PVC (size) (material)			
(6) pump 1 10 (HP) (yield gpm)			
0 (type power)			
(7) electric log No (yes or no)			
(organization running log)			
(8) how well bottom plugged Backwash valve			
DRILLERS REMARKS:			

RECEIVED
 MAY 2 - 1978
 MISS. BD. OF WATER COMMISSIONERS

If well telescopes please sketch and show depths.

GROUND LEVEL

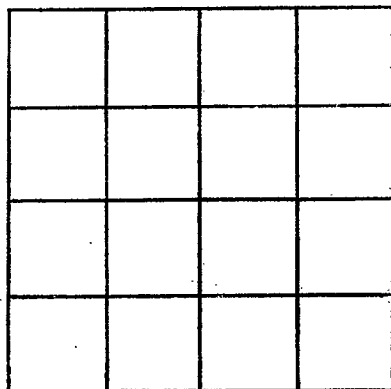

SECTION _____

Please indicate well location X.

ADDITIONAL INFORMATION

If more than one screen,
show locations of each on sketch.