

ELOG # 177

MISSISSIPPI
BOARD OF WATER COMMISSIONERS
416 North State Street
Jackson, Mississippi 39201

CODED

WATER WELL DRILLERS LOG

Yazoo
K13
1-68
File Log

1 -25 - 68 19 Bud Cresswell Yazoo
 date well completed firm name county well located

LANDOWNER:

R. D. Herren

Yazoo City, Miss.
(mailing address)

WELL LOCATION:

sec. 23 T 11 N R. 3 EX
x x W

4 miles south of Yazoo City
(distance) (direction) (nearest town)

WELL PURPOSE: Domestic
(home, irrigation, municipal, industrial)

WELL COMPLETION DATA:


- (1) diameter (inches) 4 x 2
- (2) total depth (feet) 1170
- (3) static water level (feet) 30 below
top of ground. above
- (4) casing steel 140
(material) (depth)
4 if telescope see back.
(size)
- (5) screen 30 1140
(length) (depth to top)
.008, stainless
(size) (material)
- (6) pump 1 1/2 30
(HP) (yield gpm)

(type power)
- (7) electric log yes
(yes or no)
U. S. G. S.
(organization running log)
- (8) how well bottom plugged

description of formations encountered

from	to
0	20
20	80
140	600
600	700
700	820
820	930
930	1170

clay
sand
sandy shale
shale
sand
shale
sand

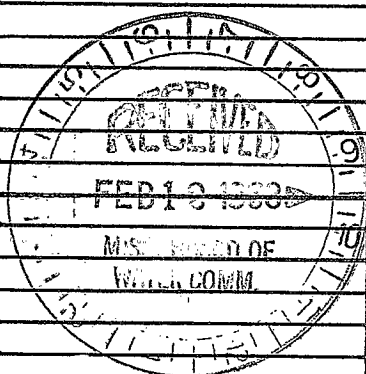

DRILLERS REMARKS:

If well telescopes please sketch and show depths.

GROUND LEVEL

SECTION 23

Please indicate well location X.

ADDITIONAL INFORMATION

If more than one screen, show locations of each on sketch.