

YAZOO  
K16  
10-13-72

MISSISSIPPI  
BOARD OF WATER COMMISSIONERS  
416 North State Street  
Jackson, Mississippi 39201

CODED

WATER WELL DRILLERS LOG

Oct. 13 1972 E.M. "Bud" Cresswell Yazoo  
date well completed firm name county well located

LANDOWNER:  
Dr. E. E. Robinson, Jr.  
Yazoo City, Miss.  
(mailing address)

description of formations encountered	from	to
Clay	0	20
Sand - gravel	20	89

WELL LOCATION:  
sec. 20 T 11 N R 3 E  
7 miles South of Yazoo  
(distance) (direction) (nearest town)

WELL PURPOSE: Farm  
(home, irrigation, municipal, industrial)

- WELL COMPLETION DATA:
- (1) diameter (inches) 2
  - (2) total depth (feet) 89
  - (3) static water level (feet) 20 below top of ground.
  - (4) casing Steel 84 (material) (depth)
  - 2 (size) if telescope see back.
  - (5) screen 5 84 (length) (depth to top)
  - 2 Stainless (size) (material)
  - (6) pump 3/4 10 (HP) (yield gpm)
  - 0 (type power)
  - (7) electric log 0 (yes or no)
  - 6 (organization running log)

CODED

(8) how well bottom plugged  
Steel plug


DRILLERS REMARKS:

NOV - 2 1972

MISS. ST. OF WATER COMMISSIONERS

If well telescopes please  
sketch and show depths.

GROUND LEVEL

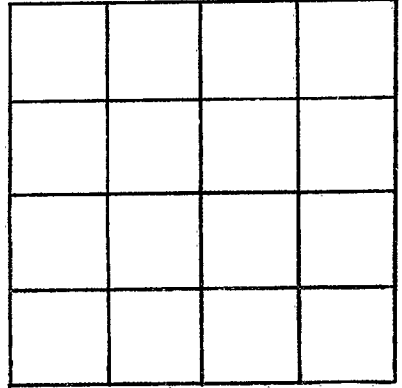

SECTION \_\_\_\_\_

Please indicate well location X.

ADDITIONAL INFORMATION

If more than one screen,  
show locations of each on sketch.