

Y4200
K17
5-10-75
E Log # 269

MISSISSIPPI
BOARD OF WATER COMMISSIONERS
416 North State Street
Jackson, Mississippi 39201

COPY

WATER WELL DRILLERS LOG

5-10 1975 Jeffcoat Drilling Co Yazoo
date well completed firm name county well located

LANDOWNER: William C. Taylor
Yazoo City Miss Rt 1
(mailing address)

description of formations encountered	from	to
Clay	0	80
gravel	80	98
Clay	98	130
fine sand	136	188
shale	186	218
sand	218	240
sandy shale	240	406
sand	406	559
shale	559	593
		T.D.

WELL LOCATION:
sec. 36T 11N R. 3E
2 1/2 miles N of Jenard
(distance) (direction) (nearest town)

WELL PURPOSE:
(home, irrigation, municipal, industrial)

- WELL COMPLETION DATA:
- (1) diameter (inches) 4"
 - (2) total depth (feet) 529
 - (3) static water level (feet) 189 below above top of ground.
 - (4) casing steel, 489,
(material) (depth)
4" if telescope see back.
(size)
 - (5) screen 40ft, 489
(length) (depth to top)
4", stainless steel
(size) (material)
 - (6) pump 1 1/2 17
(HP) (yield gpm)
AC
(type power)
 - (7) electric log yes
(yes or no)
M.S.S.
(organization running log)
 - (8) how well bottom plugged steel
plug


DRILLERS REMARKS:

RECEIVED

RECEIVED
MAY 20 1975

If well telescopes please
sketch and show depths.

GROUND LEVEL

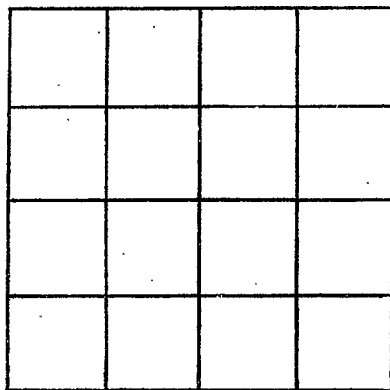

SECTION _____

Please indicate well location X.

ADDITIONAL INFORMATION

If more than one screen,
show locations of each on sketch.