

**MISSISSIPPI  
BOARD OF WATER COMMISSIONERS**  
416 North State Street  
Jackson, Mississippi 39201

**WATER WELL DRILLERS LOG**

*Yazoo*  
*K19*  
*1-68*

Jan. 3 19 68 Dyer Well & Irr. Ser. Yazoo  
date well completed firm name county well located


LANDOWNER: T. R. Coleman  
R. R. Yazoo City  
Mississippi  
(mailing address)

description of formations encountered	from	to
Clay	0	17
Fine sand	17	33
Coarse sand & gravel	33	53
Sand gravel and clay	53	63
Sand & gravel	63	83
Clay	83	125

WELL LOCATION:  
sec 1 T 11 N R 3 E X  
S W  
(distance) miles of (direction) (nearest town)

WELL PURPOSE: Fish  
(home, irrigation, municipal, industrial)

- WELL COMPLETION DATA:
- (1) diameter (inches) 16"
  - (2) total depth (feet) 83'
  - (3) static water level (feet) 19' below top of ground.
  - (4) casing Blk. Ir. 51',  
(material) (depth)  
if telescope see back.  
(size)
  - (5) screen 32' , 51'  
(length) (depth to top)  
16" , Blk. Ir.  
(size) (material)
  - (6) pump 40 2,000  
(HP) (yield gpm)  
Elec.  
(type power)
  - (7) electric log No  
(yes or no)  
(organization running log)
  - (8) how well bottom plugged Plate  
welded on bottom

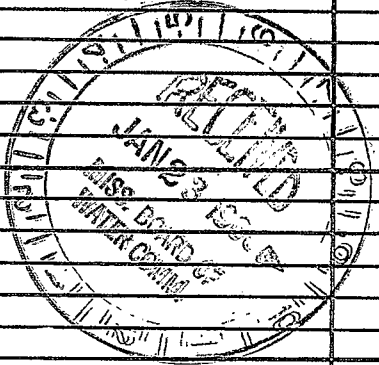

DRILLERS REMARKS:

②  
If well telescopes please sketch and show depths.

GROUND LEVEL

X			

SECTION 1

Please indicate well location X.

ADDITIONAL INFORMATION

If more than one screen,  
show locations of each on sketch.