

MISSISSIPPI
 BOARD OF WATER COMMISSIONERS
 416 North State Street
 Jackson, Mississippi 39201

CODED

WATER WELL DRILLERS LOG

YAZOO
 K 22
 7-67

July 30 1967 McCConnell Drilling Co Yazoo
 date well completed firm name county well located

LANDOWNER: E. A. Howes

Tinsley Miss.

description of formations encountered	from	to
<u>Top soil & Clay</u>	<u>0</u>	<u>100</u>
<u>Sand & fine Gravel</u>	<u>100</u>	<u>112</u>

(mailing address)

WELL LOCATION:


sec. 36 T. 11 N. R. 3 E.
 S. 5 W
4 miles N of Tinsley
 (distance) (direction) (nearest town)

WELL PURPOSE: Home
 (home, irrigation, municipal, industrial)

WELL COMPLETION DATA:

- (1) diameter (inches) 2 1/2
- (2) total depth (feet) 112'
- (3) static water level (feet) 80' ^{below} _{above} top of ground.
- (4) casing 2 1/2" Pipe, 102'
 (material) (depth)
 _____ if telescope see back.
 (size)
- (5) screen 10', 102'
 (length) (depth to top)
2", S. Steel
 (size) (material)
- (6) pump Installed own
 (HP) (yield gpm)
Elect.
 (type power)
- (7) electric log No
 (yes or no)


 (organization running log)
- (8) how well bottom plugged steel ball

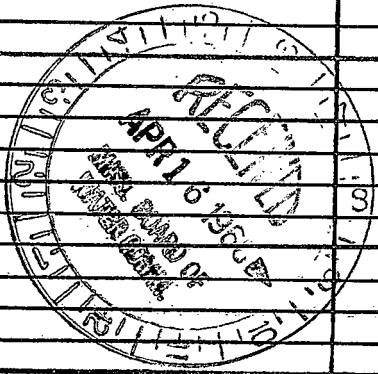

DRILLERS REMARKS: I drilled well & installed pipe & screen. He did test.

If well telescopes please sketch and show depths.

GROUND LEVEL

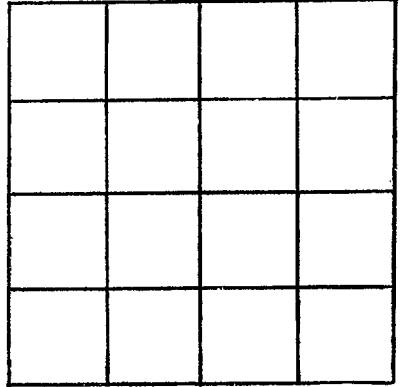

SECTION _____

Please indicate well location X.

ADDITIONAL INFORMATION

If more than one screen, show locations of each on sketch.