

YAZOO
K23
8/13/79

MISSISSIPPI
BOARD OF WATER COMMISSIONERS
416 North State Street
Jackson, Mississippi 39201

CODED

WATER WELL DRILLERS LOG

8/13, 1979 DYER WELL + IRR YAZOO
date well completed firm name county well located


LANDOWNER:	description of formations encountered	from	to
THE DELTA CO. BOX 417 BELZONI (mailing address)	CLAY SAND SAND + GRAVEL	0 60 65	60 65 110
WELL LOCATION: sec. 32-T-11 N R 3 E S W 5 miles W of YAZOO CITY (distance) (direction) (nearest town)			
WELL PURPOSE: (home, irrigation, municipal, industrial)			
WELL COMPLETION DATA:			
(1) diameter (inches) 16			
(2) total depth (feet) 110			
(3) static water level (feet) 18 above top of ground.			
(4) casing STEEL 70 (material) (depth) 16" (size) if telescope see back.			
(5) screen 40' 70 (length) (depth to top) 16 STEEL (size) (material)			
(6) pump 40 1800-2000 (HP) (yield gpm) DIESEL (type power)			
(7) electric log NO (yes or no) (organization running log)			
(8) how well bottom plugged PLATE			
DRILLERS REMARKS:			

CODED

MEAS 9-25-79
DWR

8
If well telescopes please sketch and show depths.

GROUND LEVEL

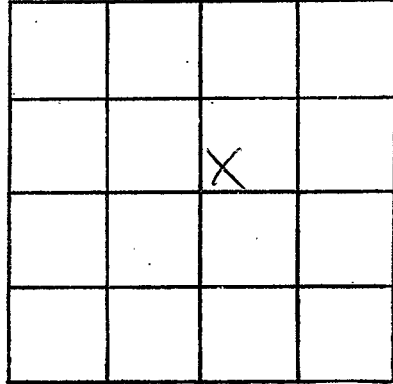

SECTION 32

Please indicate well location X.

ADDITIONAL INFORMATION

If more than one screen, show locations of each on sketch.