

YAZOO
K 24
8-10-79

MISSISSIPPI
 BOARD OF WATER COMMISSIONERS
 416 North State Street
 Jackson, Mississippi 39201

CODED

WATER WELL DRILLERS LOG

8/10 1979 DYER WELL + IRR YAZOO
 date well completed firm name county well located

LANDOWNER:
THE DELTA CO.
130X 419
BELZON'
 (mailing address)

description of formations encountered	from	to
CLAY	0	60
SAND	60	65
SAND & GRAVEL	65	113

WELL LOCATION:
 sec. 32 T. 11 N. R. 3 E
 S W
5 miles W of YAZOO CITY
 (distance) (direction) (nearest town)

WELL PURPOSE: IRRIGATION
 (home, irrigation, municipal, industrial)

WELL COMPLETION DATA:
 (1) diameter (inches) 16
 (2) total depth (feet) 113
 (3) static water level (feet) 18 below above top of ground.
 (4) casing STEEL, 73
 (material) (depth)
16" if telescope see back.
 (size)
 (5) screen 40', 73
 (length) (depth to top)
16, STEEL
 (size) (material)
 (6) pump 40, 1800-2000
 (HP) (yield gpm)
DIESEL
 (type power)
 (7) electric log N/O
 (yes or no)
 (organization running log)
 (8) how well bottom plugged PLATE


DRILLERS REMARKS:

CODED

Handwritten note: read 9-25-79

②
If well telescopes please sketch and show depths.

GROUND LEVEL

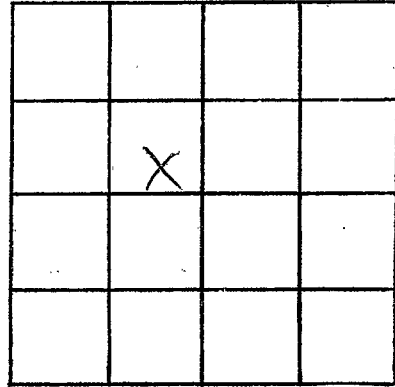

SECTION 32

Please indicate well location X.

ADDITIONAL INFORMATION

A series of horizontal lines for additional information.

If more than one screen, show locations of each on sketch.