

YAZOO  
K25  
7/26/79

MISSISSIPPI  
BOARD OF WATER COMMISSIONERS  
416 North State Street  
Jackson, Mississippi 39201

CODED

WATER WELL DRILLERS LOG

7/26/79 19. DYER WELL + IRR YAZOO  
date well completed firm name county well located

LANDOWNER:  
THE DELTA CO.  
BOX 419  
BELZONI  
(mailing address)

description of formations encountered	from	to
CLAY	0	30
FINE SAND	30	45
SAND	45	54
SAND + GRAVEL	54	113

WELL LOCATION:  
sec. 32 T-11 N R-4 E  
5 miles W of YAZOO CITY  
(distance) (direction) (nearest town)

WELL PURPOSE: IRRIGATION  
(home, irrigation, municipal, industrial)

- WELL COMPLETION DATA:
- (1) diameter (inches) 16
  - (2) total depth (feet) 113
  - (3) static water level (feet) 18 below above top of ground.
  - (4) casing STEEL 73  
(material) (depth)  
16 if telescope see back.  
(size)
  - (5) screen 40' 73  
(length) (depth to top)  
16 STEEL  
(size) (material)
  - (6) pump 40 1800-2000  
(HP) (yield gpm)  
DIESEL  
(type power)
  - (7) electric log NO.  
(yes or no)
  - (organization running log)
  - (8) how well bottom plugged PLATE


DRILLERS REMARKS:

CODED

rec'd 9.25.79  
Dyer

If well telescopes please sketch and show depths.

GROUND LEVEL

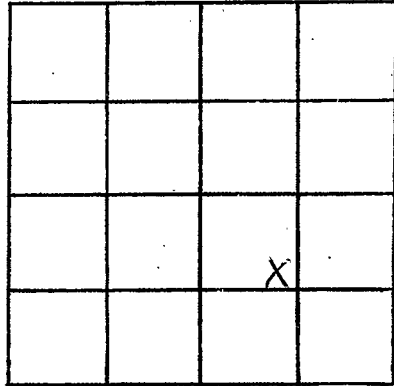

SECTION 32

Please indicate well location X.

ADDITIONAL INFORMATION

If more than one screen, show locations of each on sketch.