

YAZOO
K26
MARCH 21, 80

MISSISSIPPI
BOARD OF WATER COMMISSIONERS.
416 North State Street
Jackson, Mississippi 39201

CODED

WATER WELL DRILLERS LOG

MARCH 21 1980 E.M. "Bud" CRESSWELL 4200
date well completed firm name county well located

LANDOWNER:
Dudley Pillow
4200 City, Ms.
(mailing address)
WELL LOCATION:
sec. 34 T 11 N R. 3 W
5 miles South of 4200 City
(distance) (direction) (nearest town)

description of formations encountered	from	to
Clay	0	70
Sand - gravel	70	160
Sand	160	195
Clay	195	250
Sand	250	470
Sand - shale	420	600
Sand	760	1000

WELL PURPOSE: Home
(home, irrigation, municipal, industrial)

WELL COMPLETION DATA:
(1) diameter (inches) 4 x 2
(2) total depth (feet) 1000
(3) static water level (feet) 22 below top of ground.
(4) casing Steel, 970
(material) (depth)
4 if-telescope see back.
(size)
(5) screen 30, 970
(length) (depth to top)
2, STAINLESS
(size) (material)
(6) pump 1, 25
(HP) (yield gpm)
0
(type power)
(7) electric log Yes
(yes or no)
State Geol. Surveys
(organization running log)

CODED

(8) how well bottom plugged
back wash valve
DRILLERS REMARKS:


DEPT. OF NATURAL RESOURCES
BUREAU OF LAND & WATER RESOURCES

APR - 4 1980

RECEIVED

If well telescopes please sketch and show depths.

GROUND LEVEL

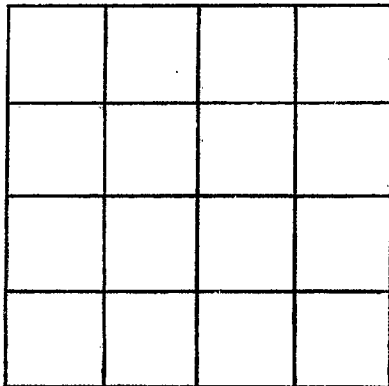

SECTION _____

Please indicate well location X.

ADDITIONAL INFORMATION

If more than one screen, show locations of each on sketch.