

Bureau of Land and Water Resources  
 Southport Mall  
 P.O. Box 10631

Jackson, Mississippi 39209  
**WATER WELL DRILLERS LOG**

00017

Yazoo  
K 31  
1-26-81

1/26 19 81 Dyer Y 03:00  
 date well completed film name county well located


LANDOWNER:  
TOMMY BOND  
YAZOO CITY, MS  
 (mailing address)

description of formations encountered	CODED	from	to
<u>Clay</u>		<u>0</u>	<u>28</u>
<u>fine sand</u>		<u>28</u>	<u>48</u>
<u>sand</u>		<u>48</u>	<u>58</u>
<u>sand + gravel</u>		<u>58</u>	<u>113</u>

WELL LOCATION:  
 sec. 15 T. 110 N. R. 3 E. S. 5  
3 miles W of Yazoo City  
 (distance) (direction) (nearest town)

WELL PURPOSE: Irrigation  
 (home, irrigation, municipal, industrial)

- WELL COMPLETION DATA:
- (1) diameter (inches) 16"
  - (2) total depth (feet) 113'
  - (3) static water level (feet) 19' below top of ground.
  - (4) casing Steel 113'  
 (material) (depth)  
16" if telescopic see back.  
 (size)
  - (5) screen 40' 7.5'  
 (length) (depth to top)  
16" Steel  
 (size) (material)
  - (6) pump 60 3000  
 (HP) (yield gpm)  
Diesel  
 (type power)
  - (7) electric log (yes or no) \_\_\_\_\_  
 (organization—running log) \_\_\_\_\_
  - (8) how well bottom plugged plate

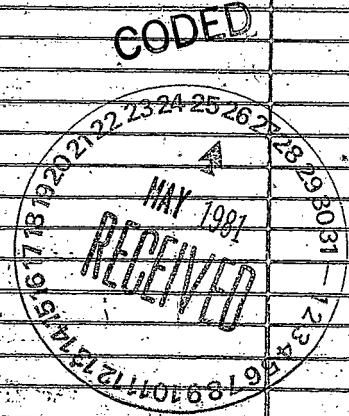

DRILLERS' REMARKS:

	x		

See 15