

ELOG # 191

CODED

CODED

MISSISSIPPI BOARD OF WATER COMMISSIONERS
416 North State Street
Jackson, Mississippi 39201

WATER WELL DRILLERS LOG

YAZOO
K39
7-29-68

7-29 1968 Bud Cresswell Yazoo
date well completed firm name county well located

LANDOWNER:
Rayford Ables
Panther Swamp
Yazoo City, Miss.
(mailing address)

WELL LOCATION:
sec 8 16 11 N R 3 W
4 miles south of Yazoo
(distance) (direction) (nearest town)


WELL PURPOSE: Domestic
(home, irrigation, municipal, industrial)

WELL COMPLETION DATA:

- (1) diameter (inches) 4 x 2
- (2) total depth (feet) 1132
- (3) static water level (feet) 4 below top of ground.
- (4) casing black, 168 (material), (depth), 4 (size) if telescope see back.
- (5) screen 30, 1060 (length), (depth to top) 008, stainless (size), (material)
- (6) pump (HP) (yield gpm) (type power)
- (7) electric log (yes or no) (organization running log)
- (8) how well bottom plugged

description of fomations encountered	from	to
clay	0	30
sand	30	100
sand gravel	100	160
sand grey	160	185
shale	185	245
sand	245	320
shale streaks sand	320	470
shale	470	760
sand fine	760	870
shale hard	870	900
sand fine	900	1000
sandy shale	1000	1055
sand good	1055	1108
shale	1108	1132

CODED

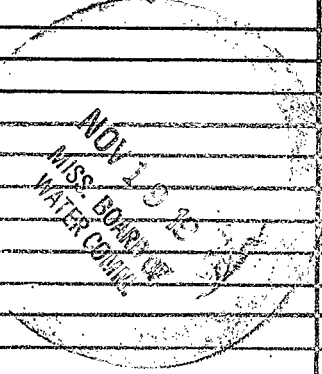

DRILLERS REMARKS:

If well telescopes please sketch and show depths.

GROUND LEVEL

SECTION 9

Please indicate well location X.

ADDITIONAL INFORMATION

If more than one screen, show locations of each on sketch.