

MISSISSIPPI DEPARTMENT OF NATURAL RESOURCES

Bureau of Land and Water Resources

Southport Mall

P.O. Box 10631

Jackson, Mississippi 39209

WATER WELL DRILLERS LOG

**CODED**

*Griner Drilling Service, Inc.*

*Yazoo*

*Yazoo*  
*R 40*  
*7-31-81*

date well completed

firm name

county well located

LANDOWNER:  
*Spooner Petroleum*  
*111 Capital Building*  
*Jackson, Ms.*  
(mailing address)

description of formations encountered	from	to
<i>Chalk</i>	<i>0</i>	<i>20</i>
<i>sand</i>	<i>20</i>	<i>100</i>
<i>Chalk</i>	<i>100</i>	<i>190</i>
<i>sand</i>	<i>190</i>	<i>252</i>
<i>Chalk</i>	<i>252</i>	<i>273</i>

WELL LOCATION: *1520'S + 1620'E*

#1 *sec 19 T 11 N R 3 E NW 1/4*  
*McGraw*  
*Curtan*  
miles of of  
(distance) (direction) (nearest town)

WELL PURPOSE: *oil field*  
(home, irrigation, municipal, industrial)  
*supply*


WELL COMPLETION DATA:

- (1) diameter (inches) *3"*
- (2) total depth (feet) *273'*
- (3) static water level (feet) *50'*  below  above top of ground.
- (4) casing *Steel*, *252'*  
(material) (depth)  
*3"*  
(size) if telescope see back.
- (5) screen *42'*, *210'*  
(length) (depth to top)  
*3"*, *perforated*  
(size) (material)
- (6) pump *70*  
(HP) (yield gpm)  
*AC*  
(type power)
- (7) electric log   
(yes or no)  
(organization running log)
- (8) how well bottom plugged *orange*  
*peel*

DEPT. OF NATURAL RESOURCES  
BUREAU OF LAND & WATER RESOURCES

AUG 26 1981


**RECEIVED**

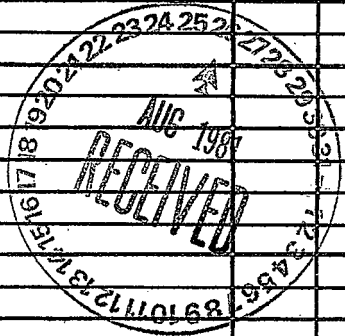

DRILLERS REMARKS:

If well telescopes please  
sketch and show depths.

GROUND LEVEL

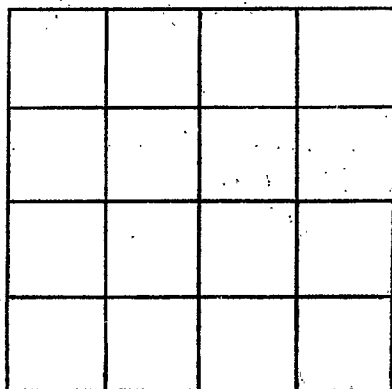

SECTION \_\_\_\_\_

Please indicate well location X.

ADDITIONAL INFORMATION

If more than one screen,  
show locations of each on sketch.